
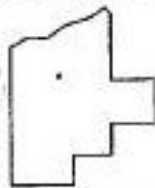


PARCEL: 02-03-008-000-003
 CHILD PARCEL: 02-03-008-000-004 & -005
 STARTING POINT: CL OF OAK TREE DR. NORTH & THE WEST LINE OF OAKS SUB. NO. 3
 ALSO THE EAST LINE OF OAKS SUB. NO. 5

NO. 00243-A

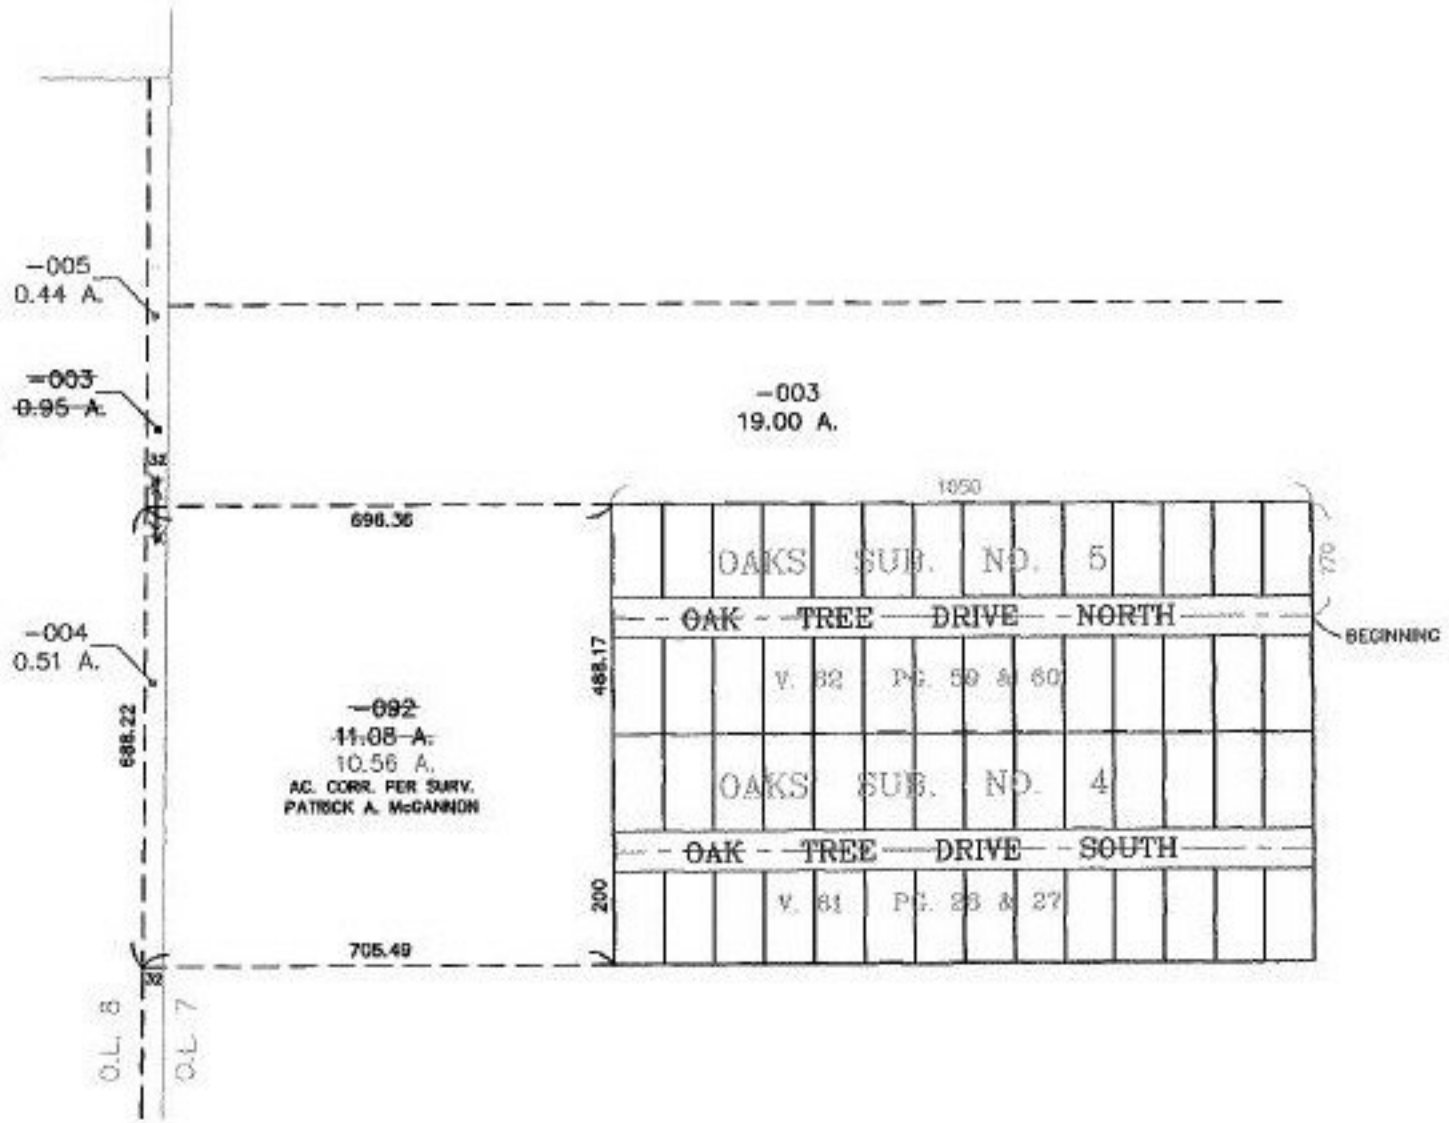

SPLITS/DEEDS PROCESSED
 LORAIN COUNTY TAX MAP DEPARTMENT
 226 MIDDLE AVE. ELYRIA, OHIO

SURVEYED BY: PATRICK A. MCGANNON
 CLOSURE: 0.01 : 10.000
 MAP PAGE(S): 02-03-007-A
 APPROVED BY: T. SPILLMAN DATE: 12/29/99
 SCALE: 1" = 300' PRIOR INSTRUMENT: 990616930