


PARENT PARCEL: 09-00-021-000-010

CHILD PARCEL: 09-00-021-000-037 & -038

STARTING POINT: MON. BOX, CL OF QUARRY RD. & CL OF RUSSIA RD.

NO. 00244

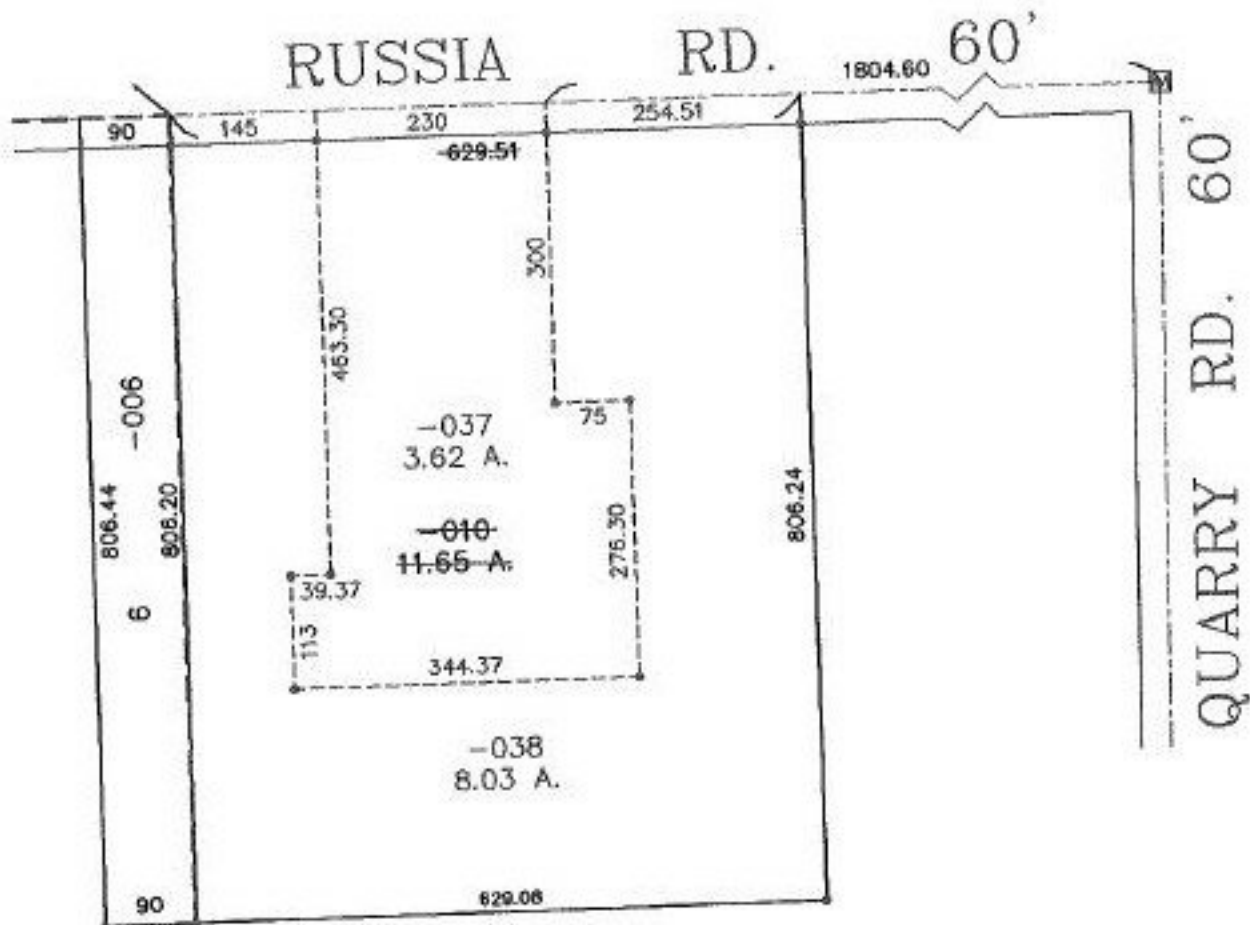

TS
2-14-00



SPLITS/DEEDS PROCESSED
LORAIN COUNTY TAX MAP DEPARTMENT
226 MIDDLE AVE. ELYRIA, OHIO

SURVEYED BY:	DAVID L. ELWELL
CLOSURE:	0.02 : 10,000
MAP PAGE(S):	09-00-021-A
APPROVED BY:	I. SPILLMAN DATE: 10/22/99
SCALE:	1" = 200' PRIOR INSTRUMENT: 990621535