
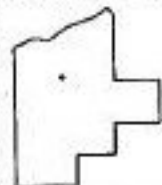


PARENT PARCEL: 12-00-096-000-049, -050, -052
CHILD PARCEL: 12-00-096-000-056
STARTING POINT: MON. BOX, CL OF HAWKE RD. & CL OF TWINSBURG-ELYRIA RD.

NO. 00246

COMBINATION

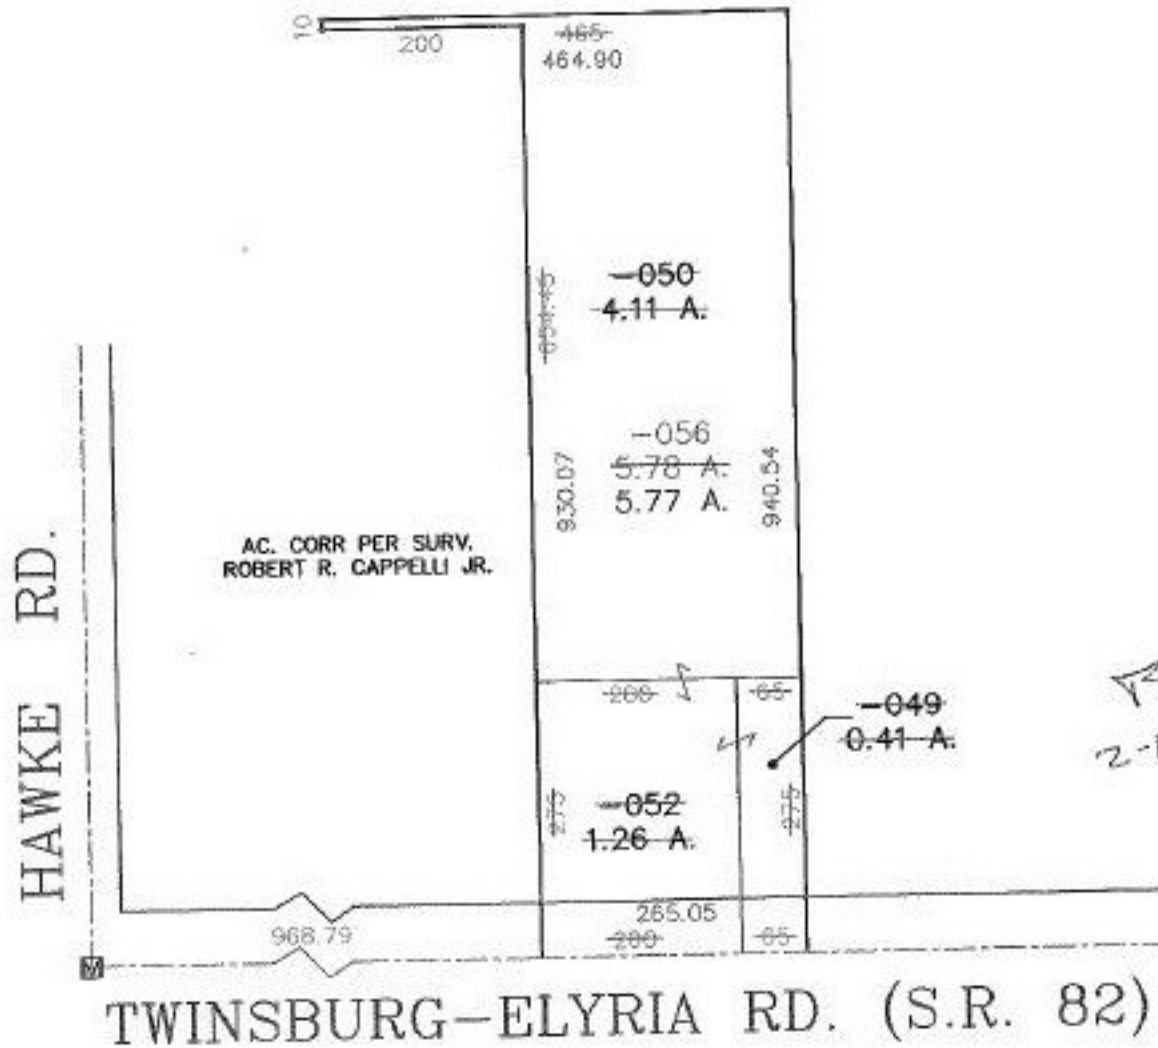

SPLITS/DEEDS PROCESSED
LORAIN COUNTY TAX MAP DEPARTMENT
226 MIDDLE AVE. ELYRIA, OHIO

SURVEYED BY: ROBERT R. CAPPELLI JR.
CLOSURE: 0.01 : 10.000
MAP PAGE(S): 12-A
APPROVED BY: J. SPILLMAN DATE: 10/21/99
SCALE: 1" = 200' PRIOR INSTRUMENT: 990641616