

PARENT PARCEL: ANNEXATION TO WELLINGTON CITY
CHILD PARCEL: XX-XX-XXX-XXX-XXX
STARTING POINT: XXXXXX

NO. 00255-X

ANNEXATION

2-14-00
AM




PARCELS GOING INTO WELLINGTON VILLAGE

- 18-00-029-000-020
2.65 A.
- 18-00-029-000-026
2.80 A.
- 18-00-029-000-028
3.10 A.
- 18-00-029-000-042
0.88 A.
- 18-00-029-000-043
66.15 A.

TAX MAP AC. CALC. 75.58 A.
RESOLUTION AC. 71.37±

ASHLAND-OBERLIN RD. (S.R. 58)

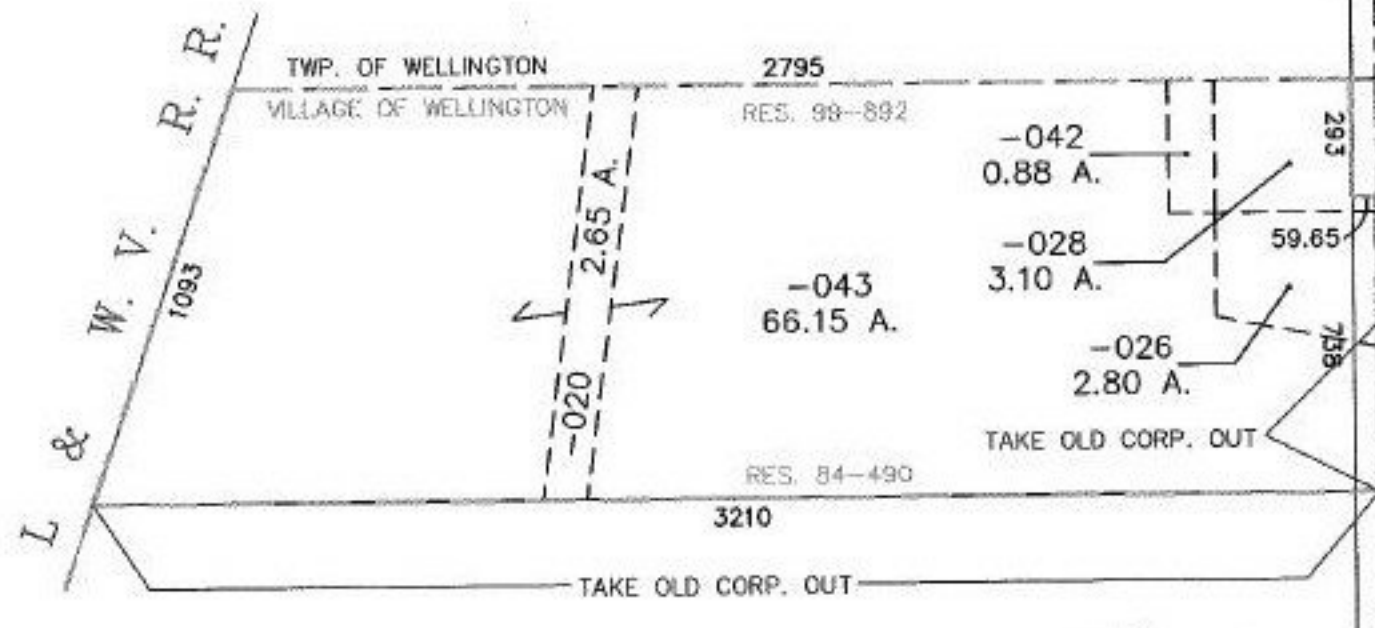

--- OLD CORP. LINE
- - - NEW CORP. LINE

TS
3-28-00

SPLITS/DEEDS PROCESSED

LORAIN COUNTY TAX MAP DEPARTMENT
226 MIDDLE AVE. ELYRIA, OHIO

SURVEYED BY: DAVID L. ELLIOTT
CLOSURE: CAN'T RUN
MAP PAGE(S): 18-00-029-D + 18-00-029-E
APPROVED BY: I. SPILLMAN DATE: 02/02/00
SCALE: 1" = 500' PRIOR INSTRUMENT: NONE