


PARENT PARCEL: 04-00-030-142-169

CHILD PARCEL: 04-00-030-142-171 & -172

STARTING POINT: MON. BOX, CL. OF WALKER RD. & THE EAST LINE OF O.L. 30

NO. 00259

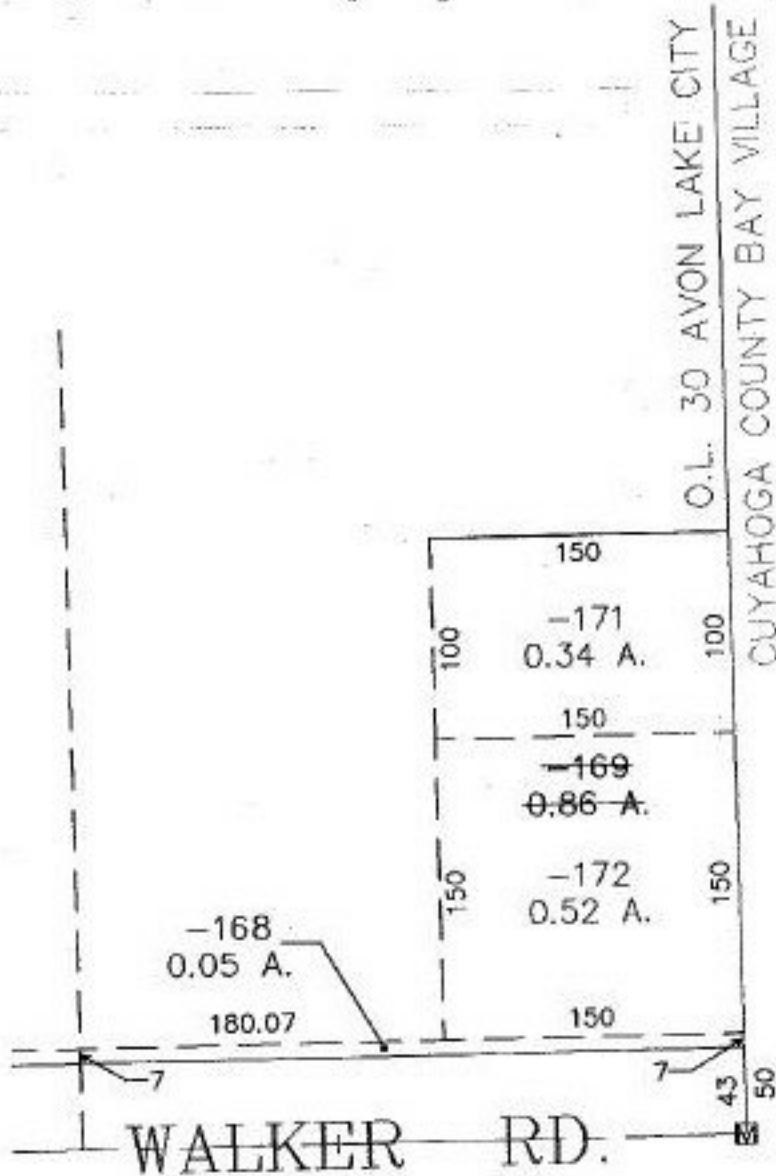

SPLITS/DEEDS PROCESSED

LORAIN COUNTY TAX MAP DEPARTMENT
226 MIDDLE AVE. ELYRIA, OHIO

SURVEYED BY: DAVID L. ELWELL

CLOSURE: 0.00 : 10.000

MAP PAGE(S): 04-00-030-H

APPROVED BY: T. SPILLMAN DATE: 11/23/99

SCALE: 1" = 100' PRIOR INSTRUMENT: 990598362