


PARENT PARCEL: 01-00-018-000-007

CHILD PARCEL: 01-00-018-000-071, -072

STARTING POINT: INT CL HIGHBRIDGE ROAD AND BROWNHELM STATION ROAD

NO. 00260

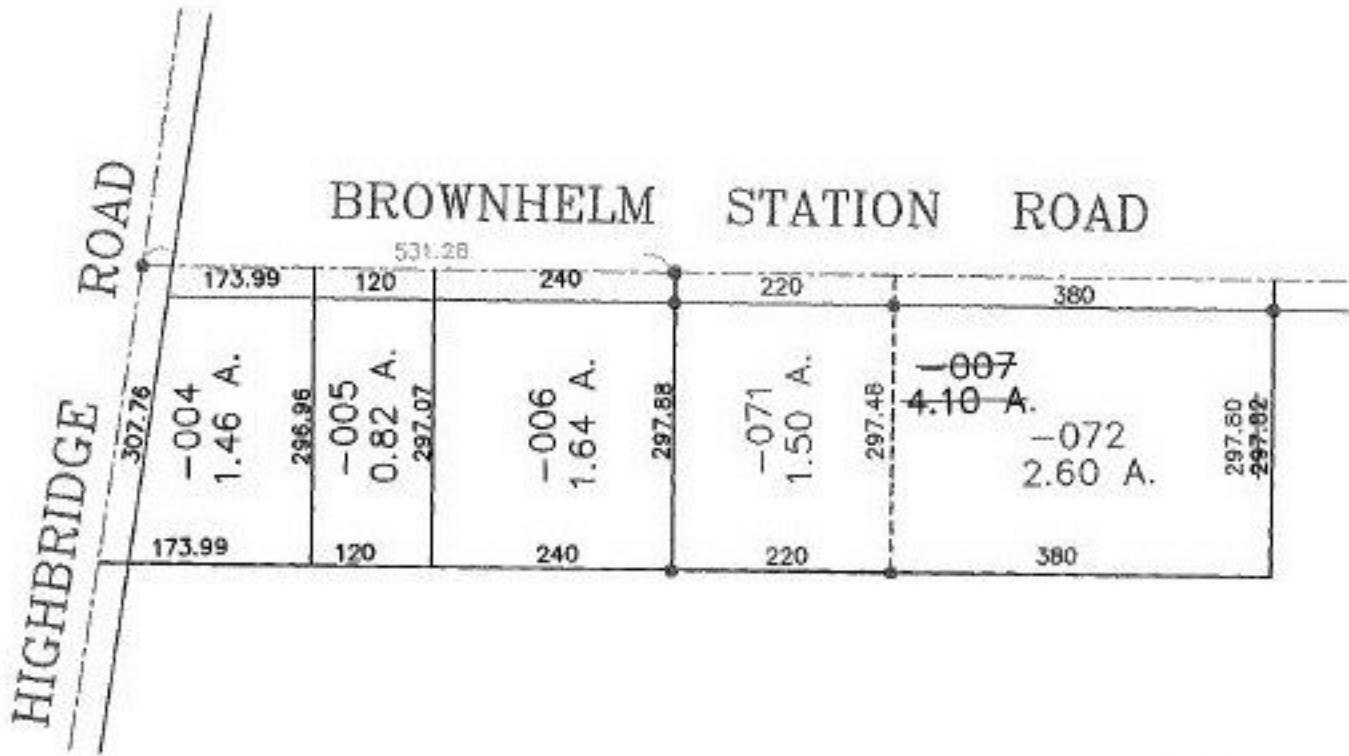

TS
3-29-00



SPLITS/DEEDS PROCESSED
LORAIN COUNTY TAX MAP DEPARTMENT
226 MIDDLE AVE. ELYRIA, OHIO

SURVEYED BY: M.G. HURA

CLOSURE: 0.08 : 10.000

MAP PAGE(S): 01-00-018-A

APPROVED BY: D.HOLLAND DATE: 11/9/99

SCALE: 1" = 200 PRIOR INSTRUMENT: #980517753