


PARENT PARCEL: 02-02-016-109-061, -053, -054 & Pt. Vac. 27th pLACE
 CHILD PARCEL: 02-02-016-109-064, 065, 066
 STARTING POINT: NORTHEASTERLY CORNER OF S/L 315 IN HILLCREST ALLOTMENT 19/32

NO. 00261



FB
 3-30-00

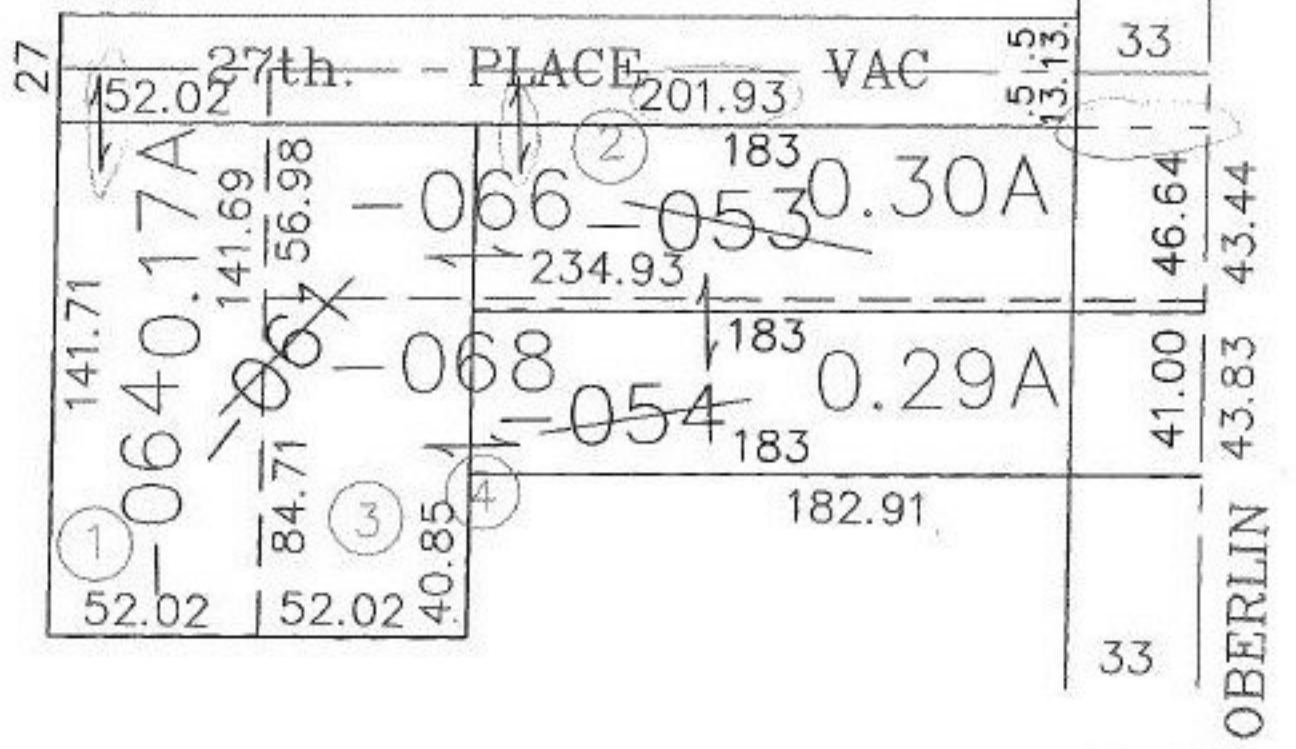

SPLITS/DEEDS PROCESSED
 LORAIN COUNTY TAX MAP DEPARTMENT
 226 MIDDLE AVE. ELYRIA, OHIO

SURVEYED BY: MARK A YEAGER
 CLOSURE: 0.03 / 10.000
 MAP PAGE(S): 2-02-016-B
 APPROVED BY: F. COLBERT DATE: 11/23/99
 SCALE: 1" = 50' PRIOR INSTRUMENT: OR 1225/509