


PARENT PARCEL: 05-00-075-000-010 & 05-00-076-000-003

CHILD PARCEL: 05-00-075-000-011, -012

STARTING POINT: C/L WEST RIDGE ROAD AT THE SOUTHEASTERLY CORNER OF O.L. 86

NO. 00262

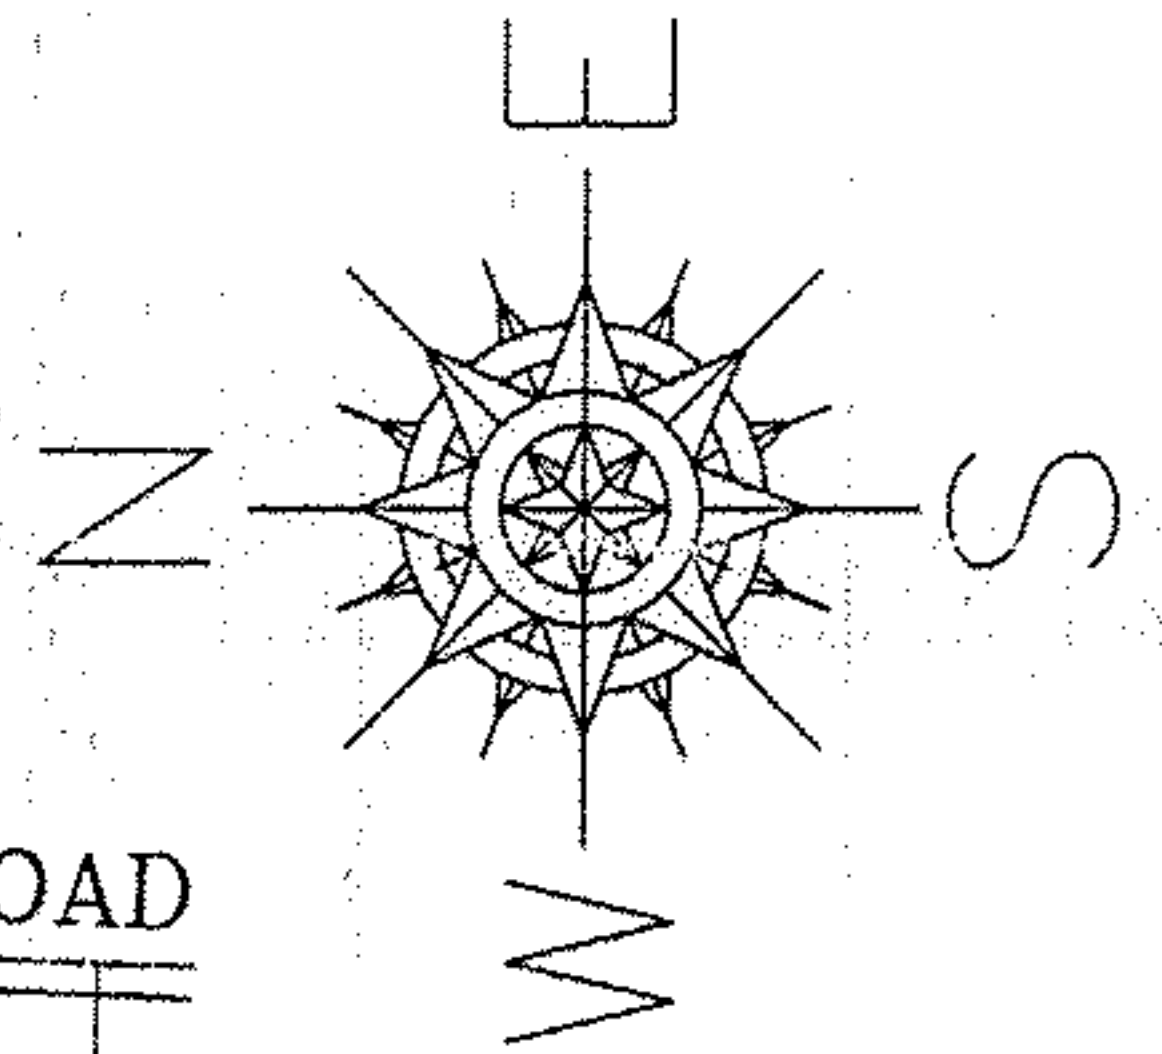

WEST RIDGE ROAD

1215.41

R.  
R.

-001  
43.21A

STRAIGHT TRANSFER

1325.17 O.L. 86

O.L. 87

2961.28

O.L. 86  
O.L. 75

ELYRIA CITY  
AMHERST TWP.

PER SURVEY OF RODGER G SIMON

-012  
~~46.68A~~  
49.12A

~~010~~  
~~79.95A~~

850.00

-009  
14.62A

O.L. 75  
659.52

O.L. 74

750.00

ELYRIA CITY  
AMHERST TWP.

1290.92

929.21

361.51

CONRAIL

-011  
33.27A

ELYRIA CITY  
AMHERST TWP.

MAY 3, 1971

O.L. 75 1322.17 ELYRIA CITY

O.L. 86

AMHERST TWP.

~~05-00-076-000-003~~

~~030-A~~

O.L. 76

1324.10

O.L. 75

SPLITS/DEEDS PROCESSED

LORAIN COUNTY TAX MAP DEPARTMENT  
226 MIDDLE AVE. ELYRIA, OHIO

SURVEYED BY: RODGER G SIMON  
CLOSURE: 0.01 / 10.000  
MAP PAGE(S): 5-H  
APPROVED BY: F. COLBERT DATE: 11/23/99  
SCALE: 1" = 400' PRIOR INSTRUMENT: DV 1038/855