


PARENT PARCEL: 10-00-005-107-515

CHILD PARCEL: 10-00-005-107-531, 532

STARTING POINT: MON. BOX AT THE C/Ls OF SPYGLASS DR. & PINEHURST AVE.

NO. 00265

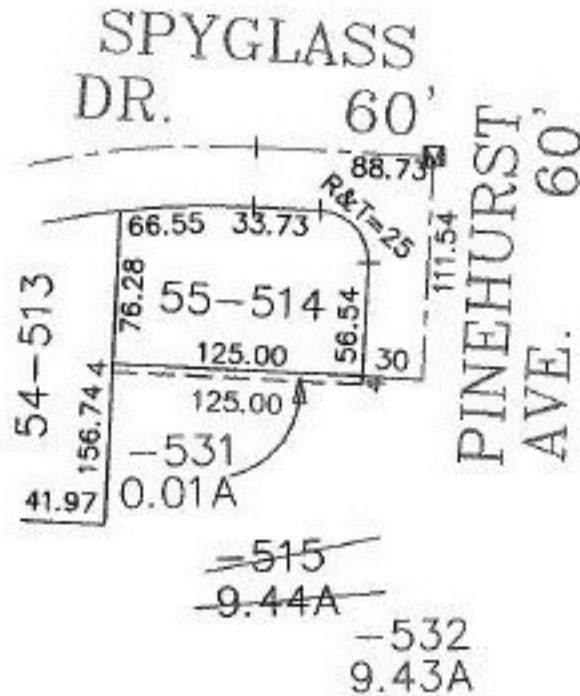

SPLITS/DEEDS PROCESSED

LORAIN COUNTY TAX MAP DEPARTMENT
226 MIDDLE AVE. ELYRIA, OHIO

SURVEYED BY: DAVID L. ELWELL

CLOSURE: 0.00 / 10,000

MAP PAGE(S): 10-00-005-E

APPROVED BY: E. COLBERT DATE: 11/29/99

SCALE: 1" = 100' PRIOR INSTRUMENT: INST980513302