


PARENT PARCEL: 06-25-001-000-191 & 10-00-005-102-421

CHILD PARCEL: 06-25-001-000-193 & -194 & 10-00-005-102-422 & -423

STARTING POINT: MON. BOX, CL OF OAKDALE CIRCLE & CL OF HAMPTON DR.

NO. 00267

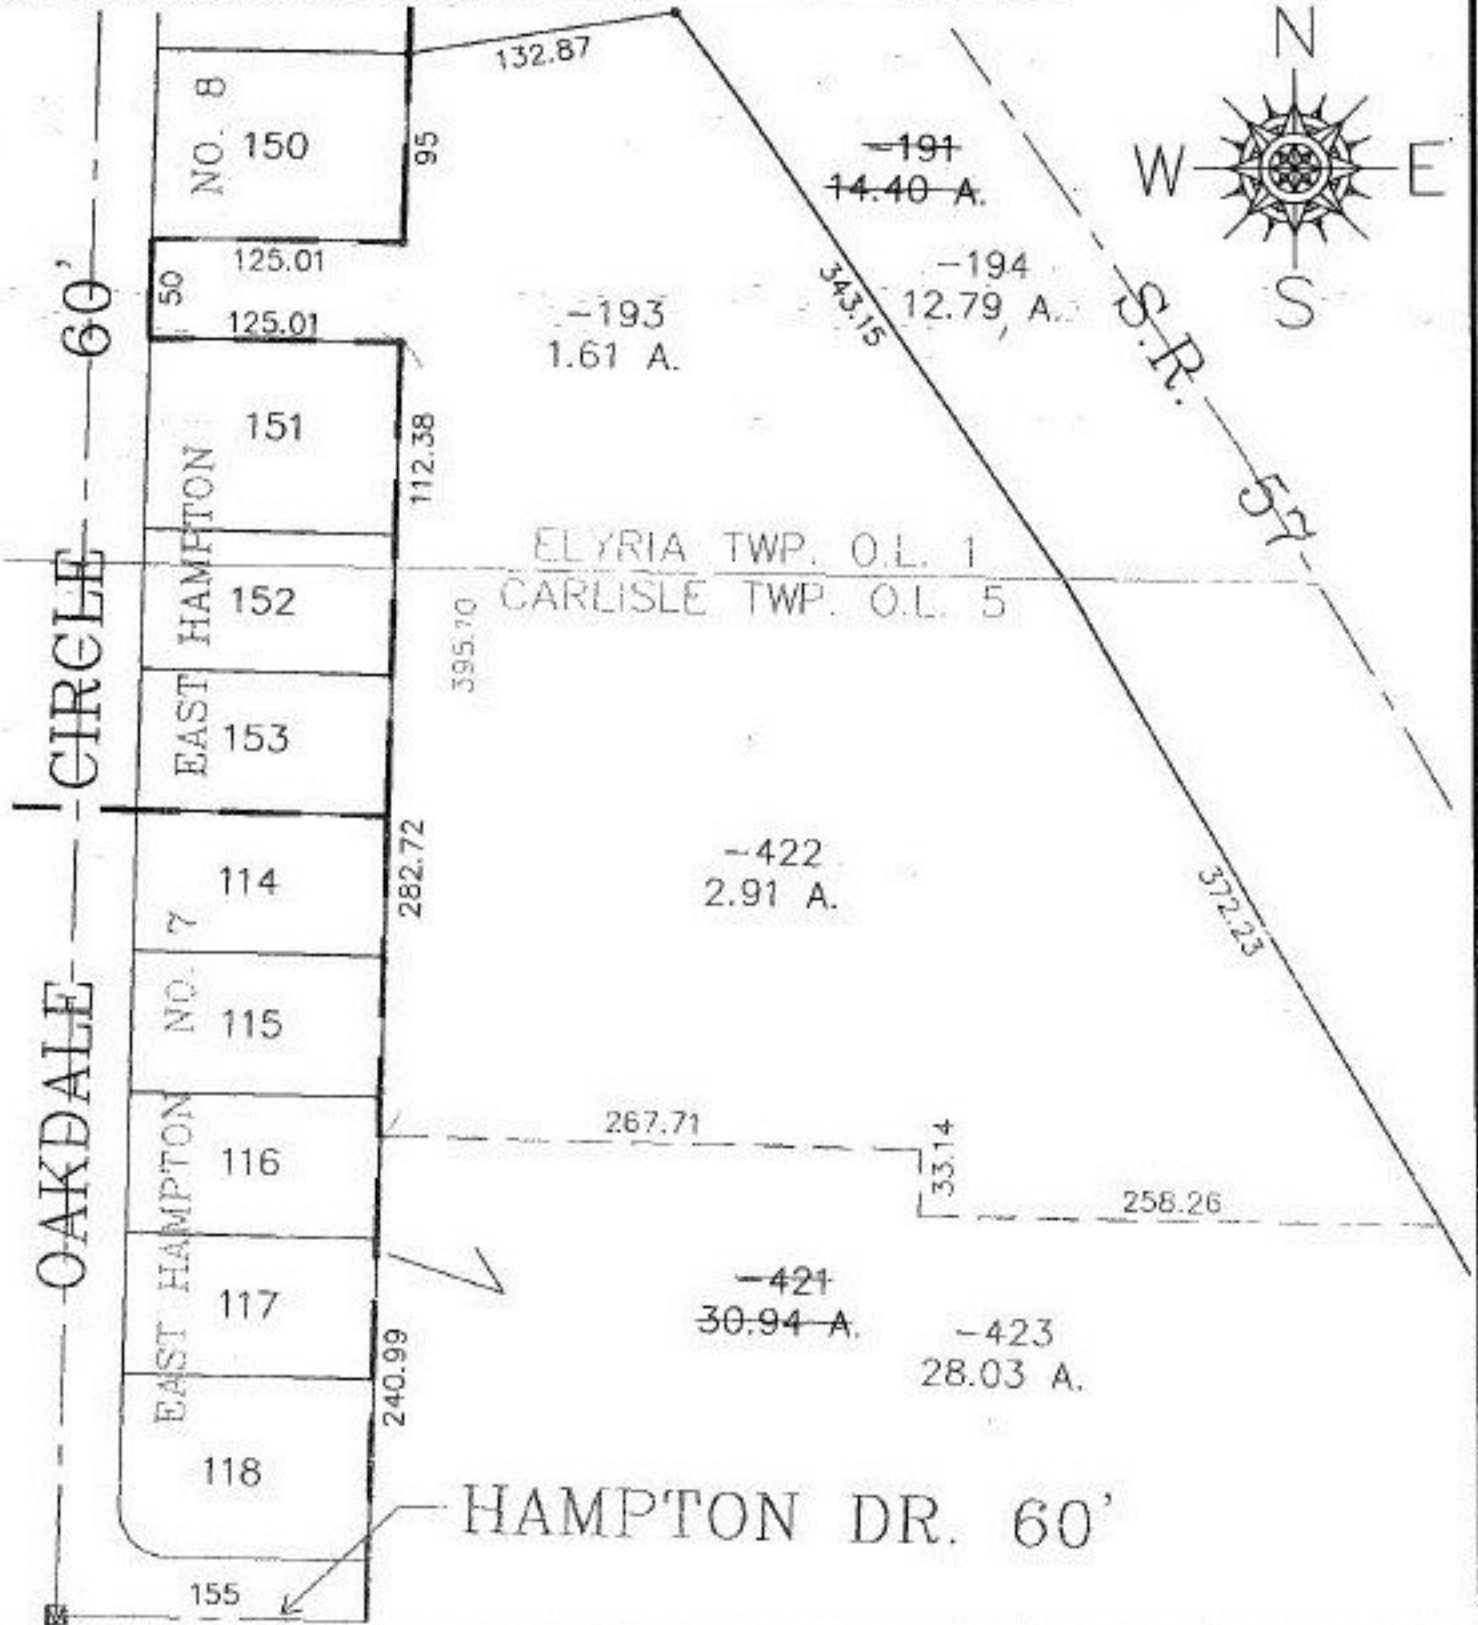

SPLITS/DEEDS PROCESSED

LORAIN COUNTY TAX MAP DEPARTMENT  
226 MIDDLE AVE. ELYRIA, OHIO

SURVEYED BY: DAVID L. ELWELL

CLOSURE: 0.04 : 10.000

MAP PAGE(S): 6-144 & 10-00-005-0

APPROVED BY: I. SPILLMAN DATE: 11/29/99

SCALE: 1" = 100' PRIOR INSTRUMENT: 980529146