


PARENT PARCEL: 18-00-040-000-016 & -017

CHILD PARCEL: 18-00-040-000-018 THRU -020

STARTING POINT: CL OF MEDINA-NORWALK RD. & WEST LINE OF O.L. 40

NO. 00270

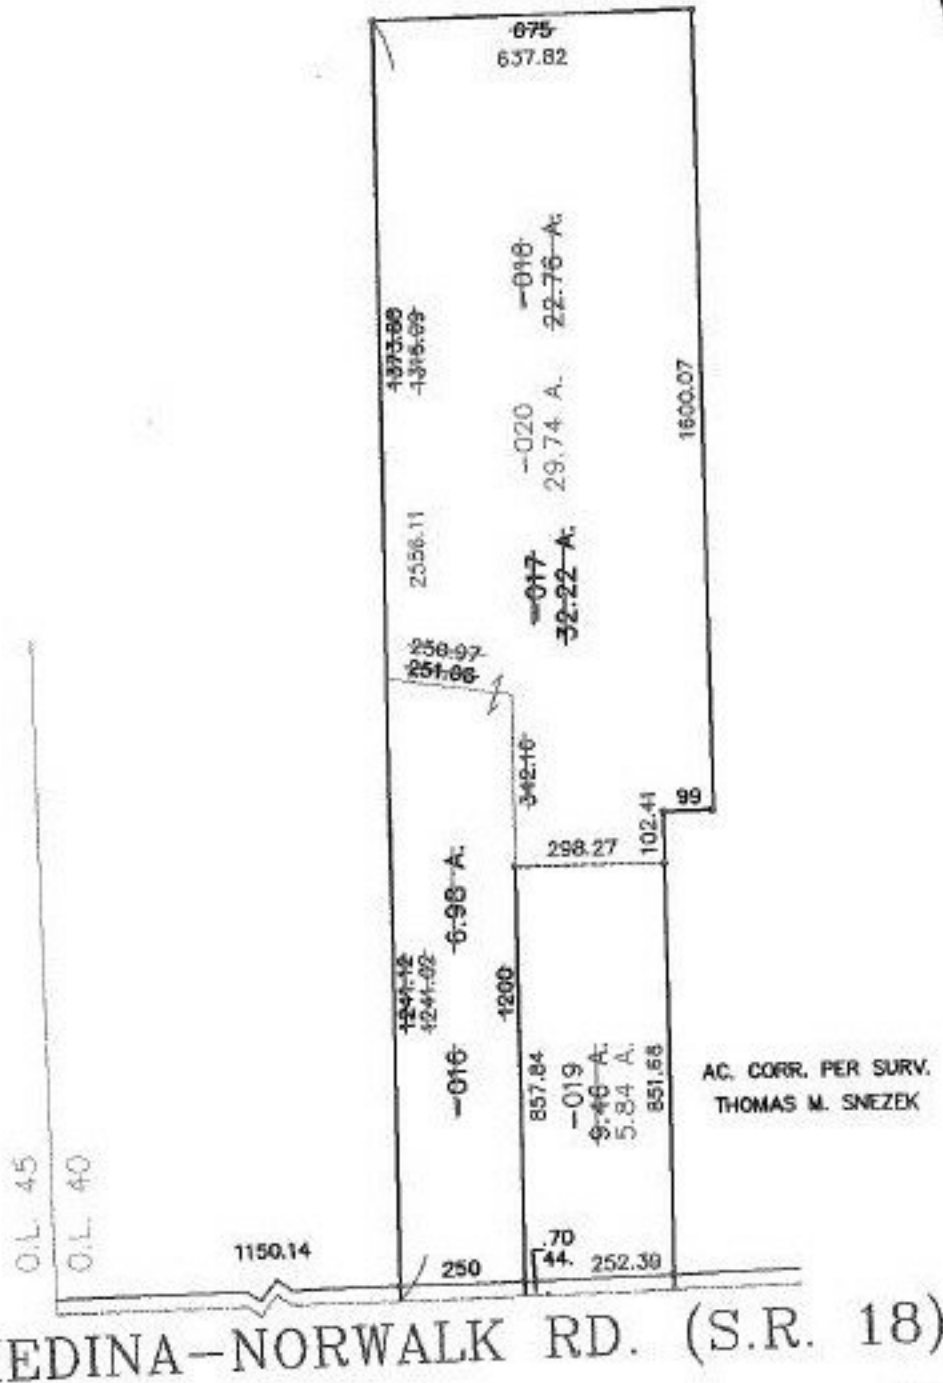

2-22-00

PRIOR INSTRUMENT: DV 1364/59
PRIOR INSTRUMENT: OR 39/491



SPLITS/DEEDS PROCESSED
LORAIN COUNTY TAX MAP DEPARTMENT
226 MIDDLE AVE. ELYRIA, OHIO

SURVEYED BY: THOMAS M. SNEZEK
CLOSURE: 0.03 : 10,000
MAP PAGE(S): 18-A
APPROVED BY: I. SPILLMAN DATE: 12/13/99
SCALE: 1" = 400'