


~~271~~

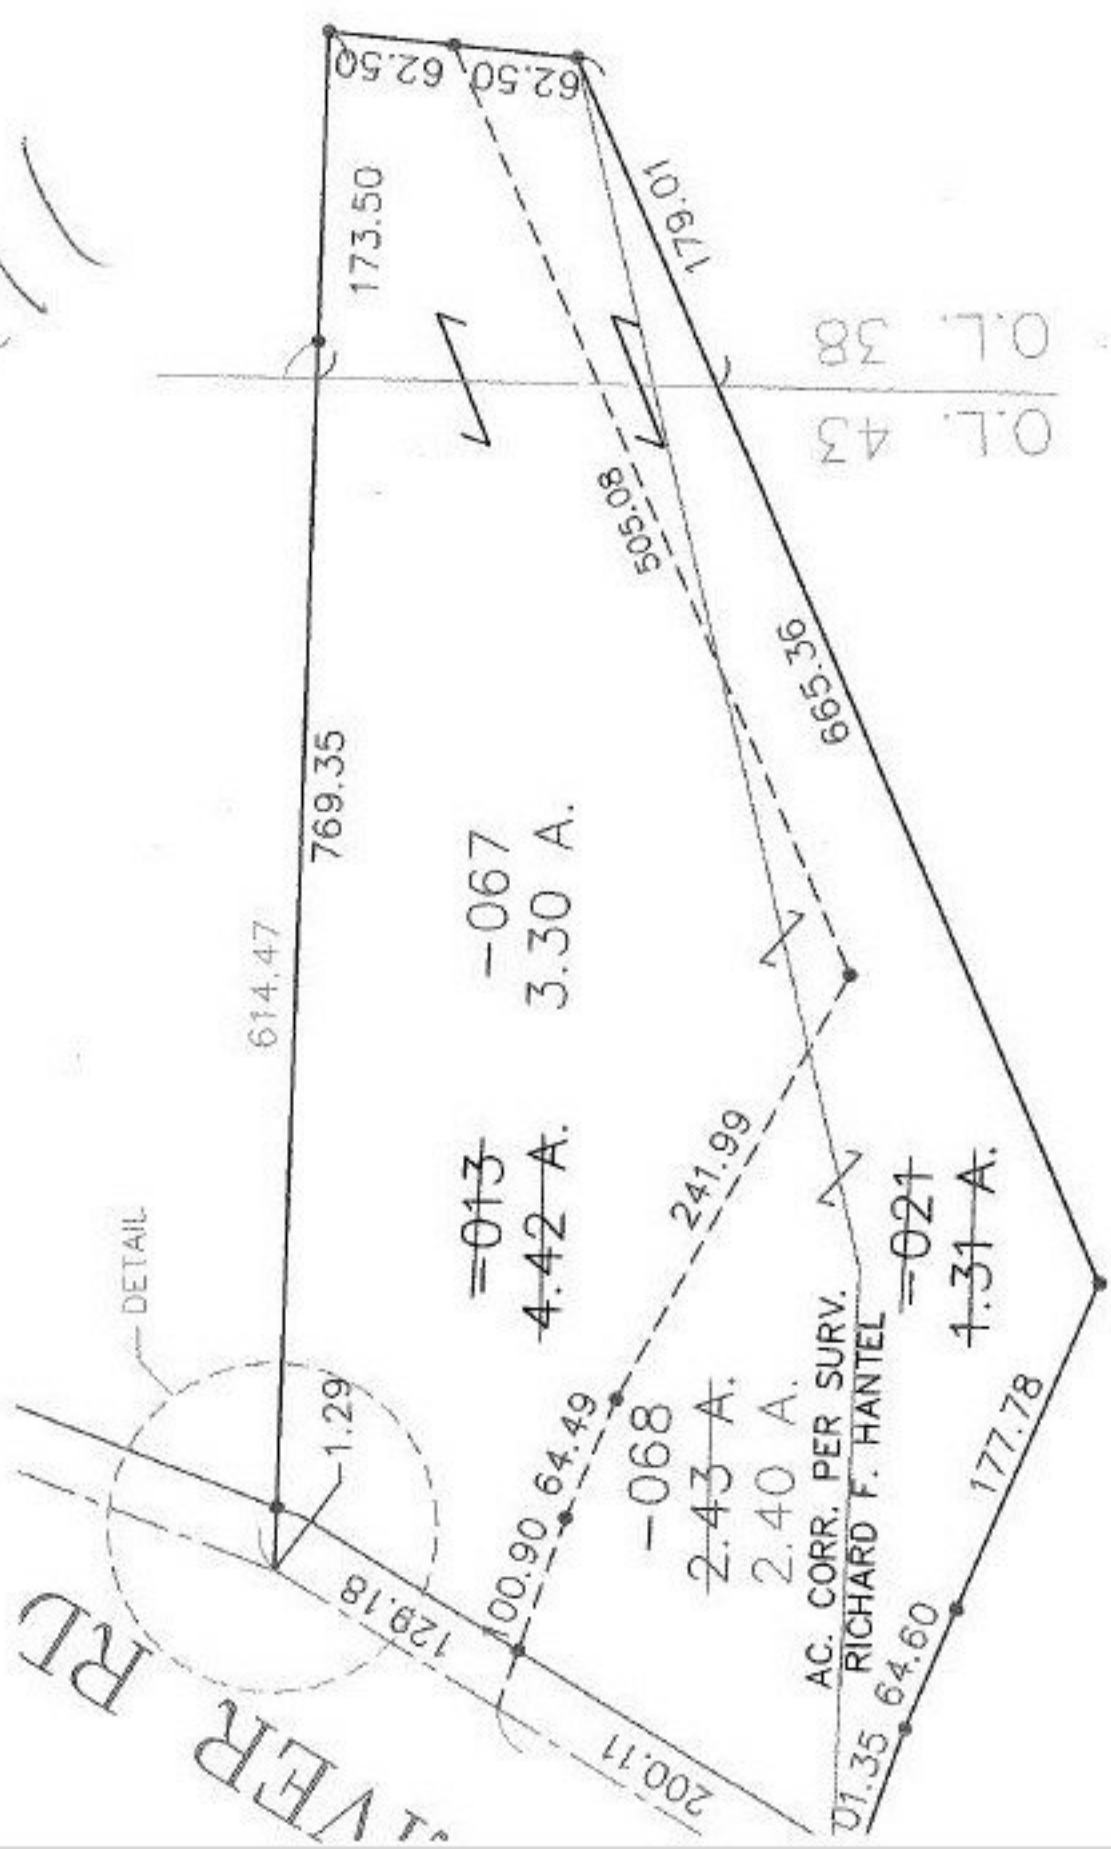

O.L. 43
O.L. 38

WATER RD