
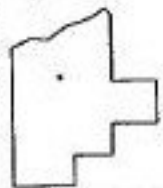


PARENT PARCEL: 04-00-011-102-112

CHILD PARCEL: 04-00-011-102-118 & -119

STARTING POINT: PK NAIL, CL OF HAYES ST. & DETROIT RD.

NO. 00272

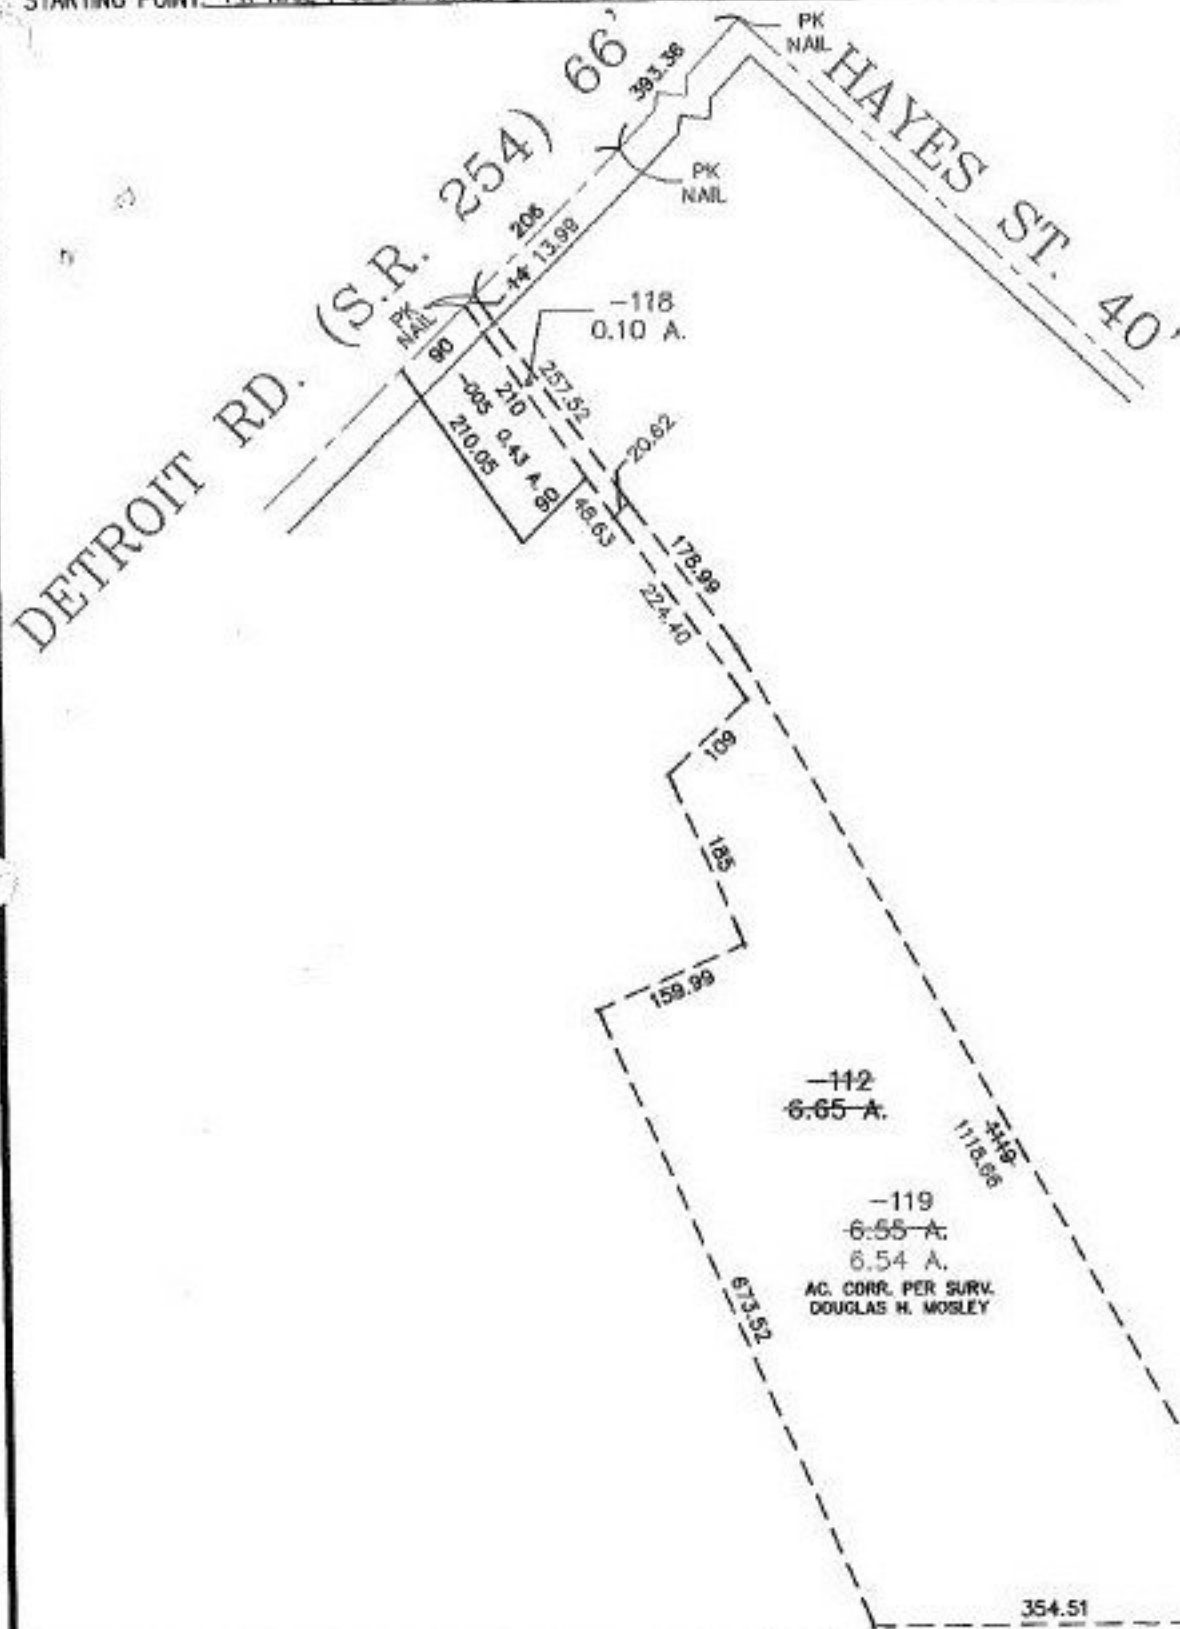

SPLITS/DEEDS PROCESSED
 LORAIN COUNTY TAX MAP DEPARTMENT
 226 MIDDLE AVE. ELYRIA, OHIO

SURVEYED BY: DOUGLAS H. MOSLEY
 CLOSURE: 0.08 : 10,000
 MAP PAGE(S): 04-00-011-B
 APPROVED BY: T. SPILLMAN DATE: 01/21/00
 SCALE: 1" = 200' PRIOR INSTRUMENT: OR 1346/66