


PARENT PARCEL: 12-00-058-000-033

CHILD PARCEL: XX-XX-XXX-XXX-XXX

STARTING POINT: R.R.S., CL OF JAQUAY RD. & CL OF NICHOLS RD.

NO. 00277-D

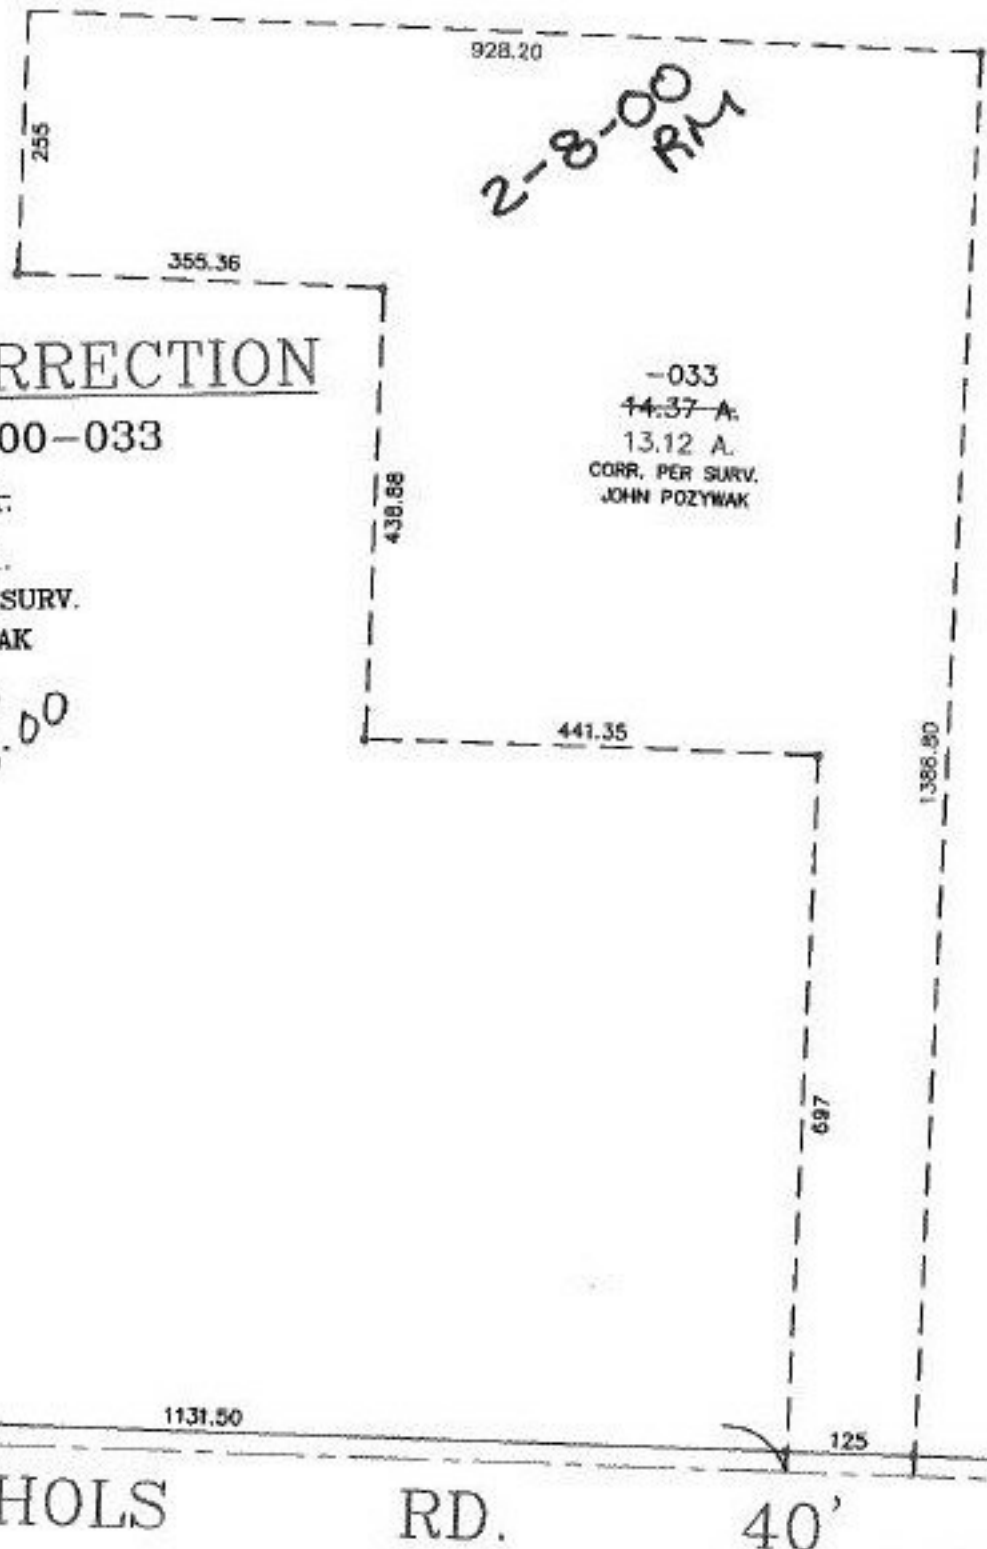

2-8-00 RM

# ACREAGE CORRECTION

12-00-058-000-033

~~14.37 A.~~

13.12 A.

AC. CORR. PER SURV.  
JOHN POZYWAK

-033  
~~14.37 A.~~  
13.12 A.  
CORR. PER SURV.  
JOHN POZYWAK

TS  
4-5-00

JAQUAY RD.

NICHOLS RD. 40'



## SPLITS/DEEDS PROCESSED

LORAIN COUNTY TAX MAP DEPARTMENT  
226 MIDDLE AVE. ELYRIA, OHIO

SURVEYED BY: JOHN POZYWAK

CLOSURE: 0.14 : 10,000

MAP PAGE(S): 12-B

APPROVED BY: I. SPILLMAN DATE: 01/24/00

SCALE: 1" = 200' PRIOR INSTRUMENT: OR 269/885