

PARENT PARCEL: 03-00-113-102-002

CHILD PARCEL: 03-00-113-102-097 & -098

STARTING POINT: MON. BOX, CL OF MIDDLE RIDGE RD. & CL OF BROADWAY AVE.

NO. 00277

SPLIT

~~03-00-113-102-002~~  
03-00-113-102-097  
03-00-113-102-098



FR. & DEPTH CORR.

03-00-113-102-090  
~~176.56 X 147.05 IRR.~~  
178.36 X 146.84 IRR.



DETAIL

NO SCALE

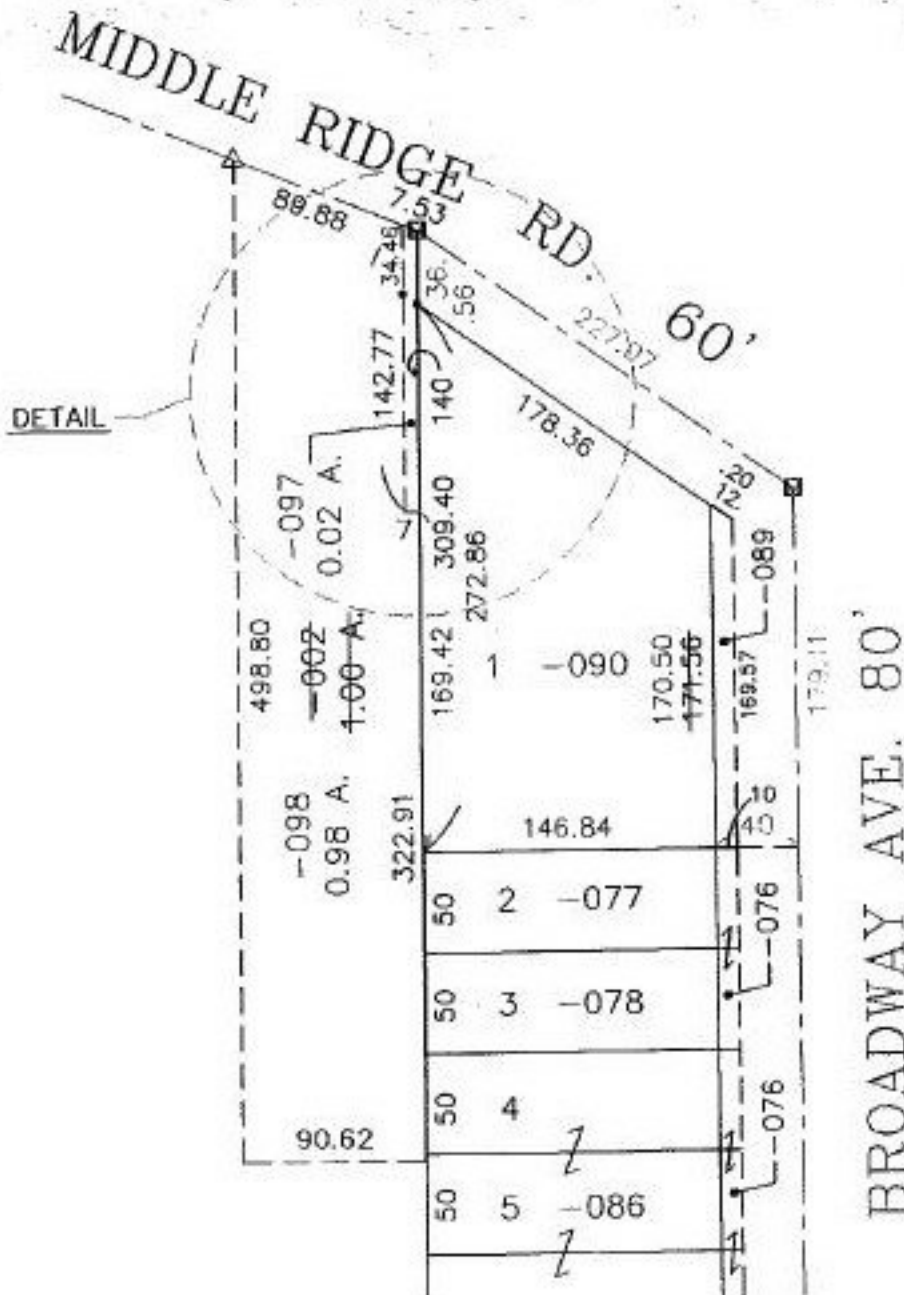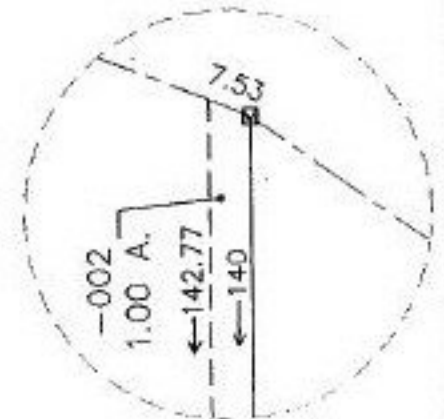

PRIOR INSTRUMENT: OR 1351/18  
PRIOR INSTRUMENT: OR 1101/001

SPLITS/DEEDS PROCESSED

LORAIN COUNTY TAX MAP DEPARTMENT  
226 MIDDLE AVE. ELYRIA, OHIO

SURVEYED BY: THOMAS A. SIMON  
CLOSURE: 0.08 : 10,000  
MAP PAGE(S): 03-00-113-A  
APPROVED BY: T. SPILLMAN DATE: 12/09/99  
SCALE: 1" = 100'