

PARENT PARCEL: 19-02-030-000-041

CHILD PARCEL: 19-02-030-000-055 & -056

STARTING POINT: MON. BOX, CL. OF SOOY RD. & CL. OF JONES RD.


NO. 00282



780.21  
303.55  
476.66

-041  
39.73-A.

-056  
36.52 A.

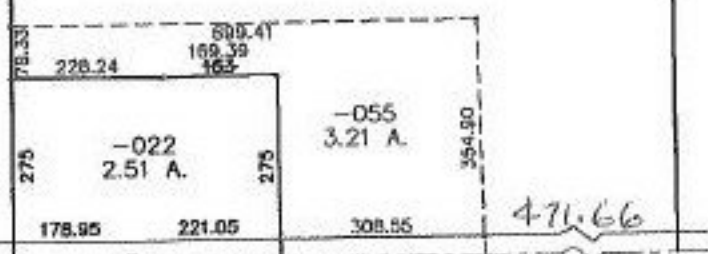

SOOY  
RD.

1154.07

JONES RD. 60'

223.00



**SPLITS/DEEDS PROCESSED**

LORAIN COUNTY TAX MAP DEPARTMENT  
226 MIDDLE AVE. ELYRIA, OHIO

SURVEYED BY: JOHN POZYWAK

CLOSURE: 0.01 : 10.000

MAP PAGE(S): 19-G

APPROVED BY: T. SPILLMAN DATE: 12/13/99

SCALE: 1" = 300' PRIOR INSTRUMENT: DV 1321/554