


1-6-00 RM #00284X

APPROVED LORAIN CO. MAP DEPT
DATE 2-3-2000 E r i
PAGE 1-00 002B
BY <i>J. [Signature]</i>
# 284

L a k e  
NEW PARCEL No. IN  
BLOCK 640  
ASSIGNED

# 284 - 7 (640) - 001  
0.06 A.  
3-29-00

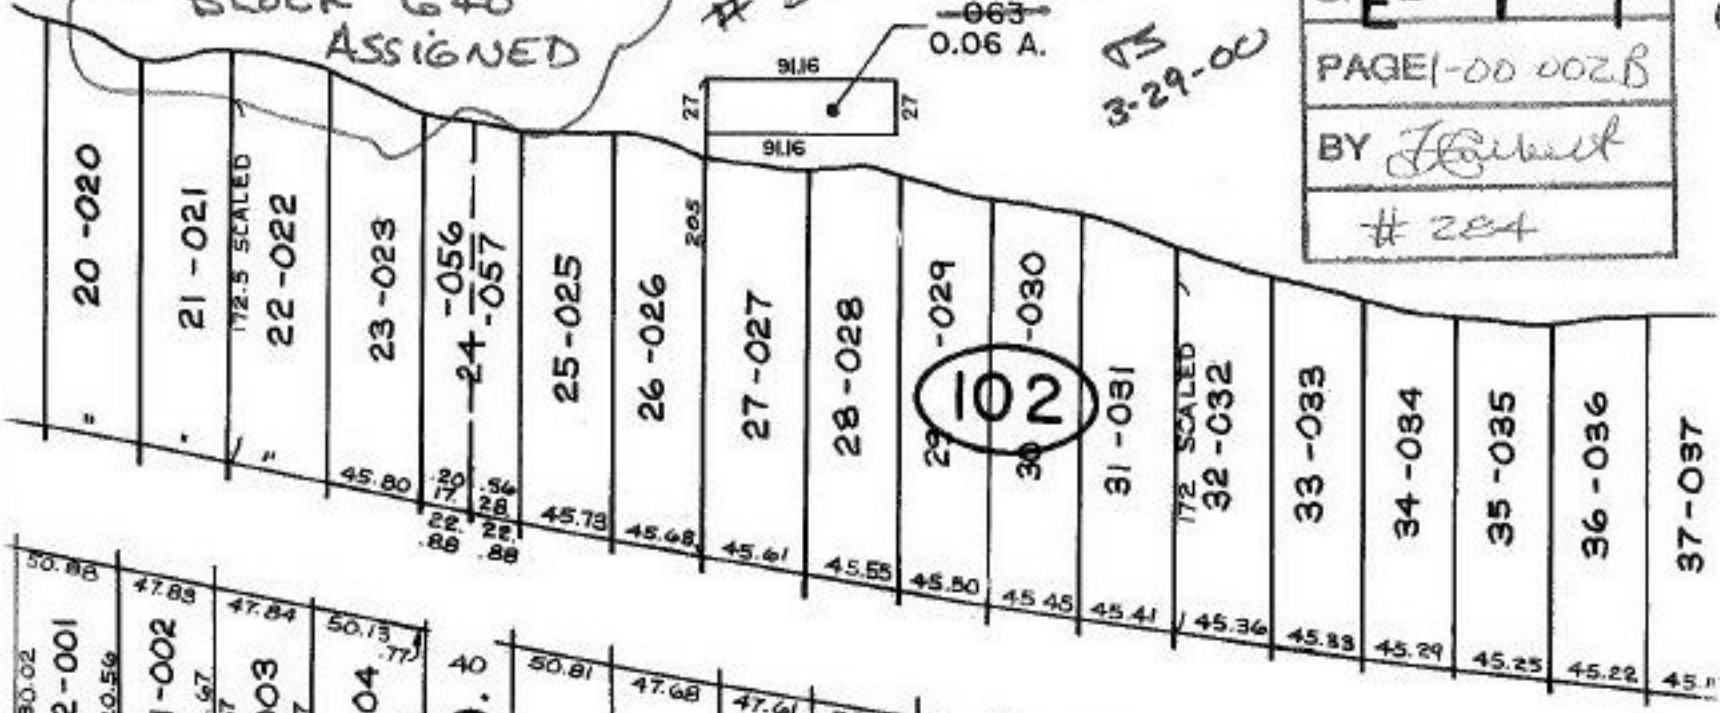

130.02 52-001	47.83 1351-002	47.84 1350-003	50.13 1349-004
120.56 1353-005	111.67 1348-040	137.77	128.31
47	97	97	35
1354	1348-040		
1355-006	1347-041		
1356-007	1346-042		
1357-008	1345-043		
1358-009	1344-044		
1359-010	1343-045		
1360-080 -081	1342		
1361	1341-046		
1362-071	1340-047		
1363-014	1339		
1364	1338-048		
1365-077	1337		
1366-017	1336-049		

RD. 40

152.98 1271-001	47.68 1270-002	47.61 1269-003	50.59 1268-004
144.07	128.46	120.75	
97	47	47	38
1272-005	1267-040		
1273-006	1266-041		
1274-007	1265-042		
1275-008	1264-043		
1276-009	1263-044		
1277-010	1262-045		
1278-011	1261-046		
1279-012	1260-047		
1280-013	1259-048		
1281-014	1258-049		
1282-015	1257-050		
1283-016	1256-084		

RD. 40

146.90 1194-001	47.41 1193-002	50.38 1192-003	56.78 1191-004
139.97	133.78	146.55	140.04
97	47	50	56 40
1195-005	1190-039		
1196-006	1189-082		
1197-007	#88		
1198-008			
1199-009	1187-081		
1200	1186-044		
1201-010	1185-045		
1202-011	1184-046		
1203-012	1183-047		
1204-013	1182-048		
1205-014	1181-049		

RD. 50

134.71 1127-001	129.19 1126-002
56.74	106.74
40	50
1128-001	
1129-006	
1130	
1131-007	
1132	
1133-008	
1134-009	
1135-010	
1136-011	
1137-012	

LAKE

UB