


PARENT PARCEL: 15-00-034-000-005


CHILD PARCEL: 15-00-034-000-018 & -019

STARTING POINT: MON. BOX, CL. OF BIGGS RD. & CL. OF WHEELER RD.

NO. 00285

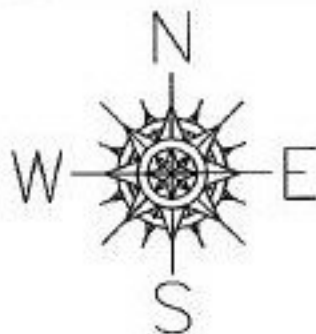

BIGGS RD. 60'

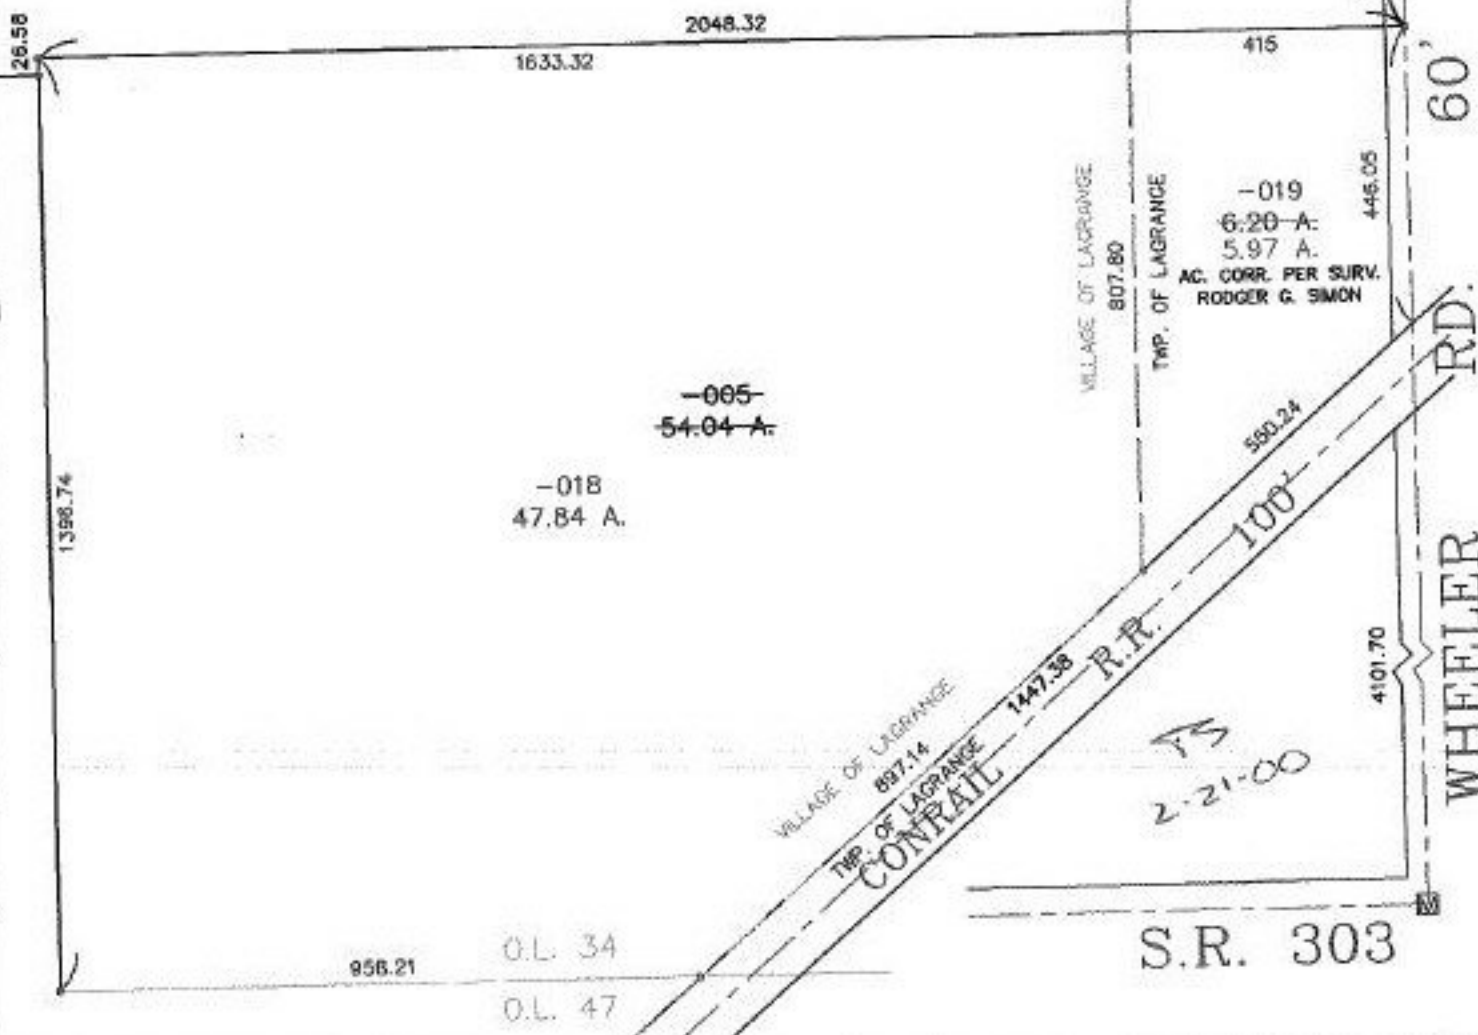

SPLITS/DEEDS PROCESSED
 LORAIN COUNTY TAX MAP DEPARTMENT
 226 MIDDLE AVE. ELYRIA, OHIO

SURVEYED BY: RODGER G. SIMON
 CLOSURE: 0.02 : 10.000
 MAP PAGE(S): 15-00-034-A & B
 APPROVED BY: I. SPILLMAN DATE: 12/06/99
 SCALE: 1" = 300 PRIOR INSTRUMENT: OR 1395/768