

#00 289-A


APPROVED
LORAIN CO.
MAP DEPT

DATE 2-18-2000

PAGE 7-00-029-D

BY *F. Haller*

289-A.

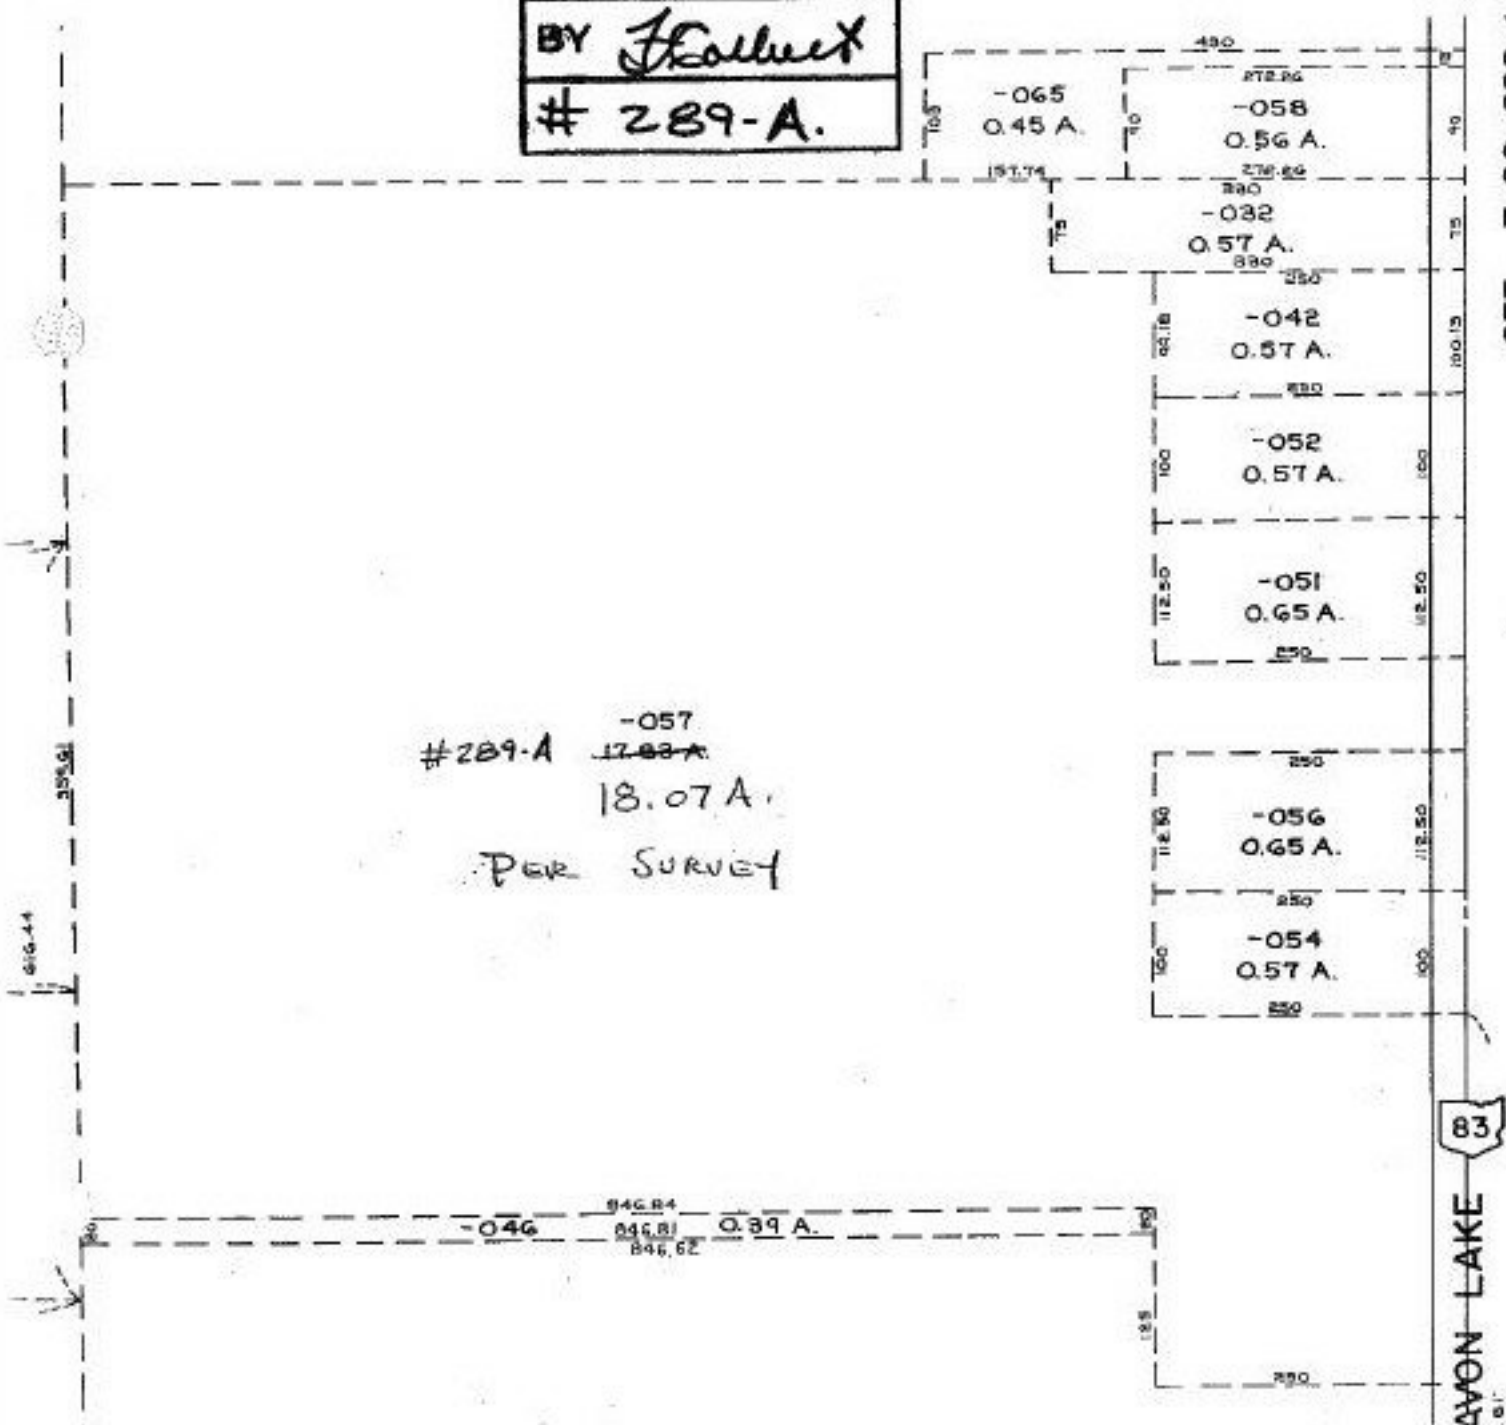

#289-A -057
17.03 A.
18.07 A.
PER SURVEY

SEE 7-00-020-(

83
AVON LAKE