

DEAN
113

BOTH DEEDS SUBMITTED NEED CORRECTION


#1 DEED NEEDS TO BE WRITTEN TO DESCRIBE -A24 ONLY.
#2 NEED ACRES TO BE CORRECTED

NO CHANGES OF TAX MAP

#00-291-D

APPROVED
LORAIN CO.
MAP DEPT
DATE 2-24-2000
PAGE 8-A
BY [Signature]
291-D

ST.

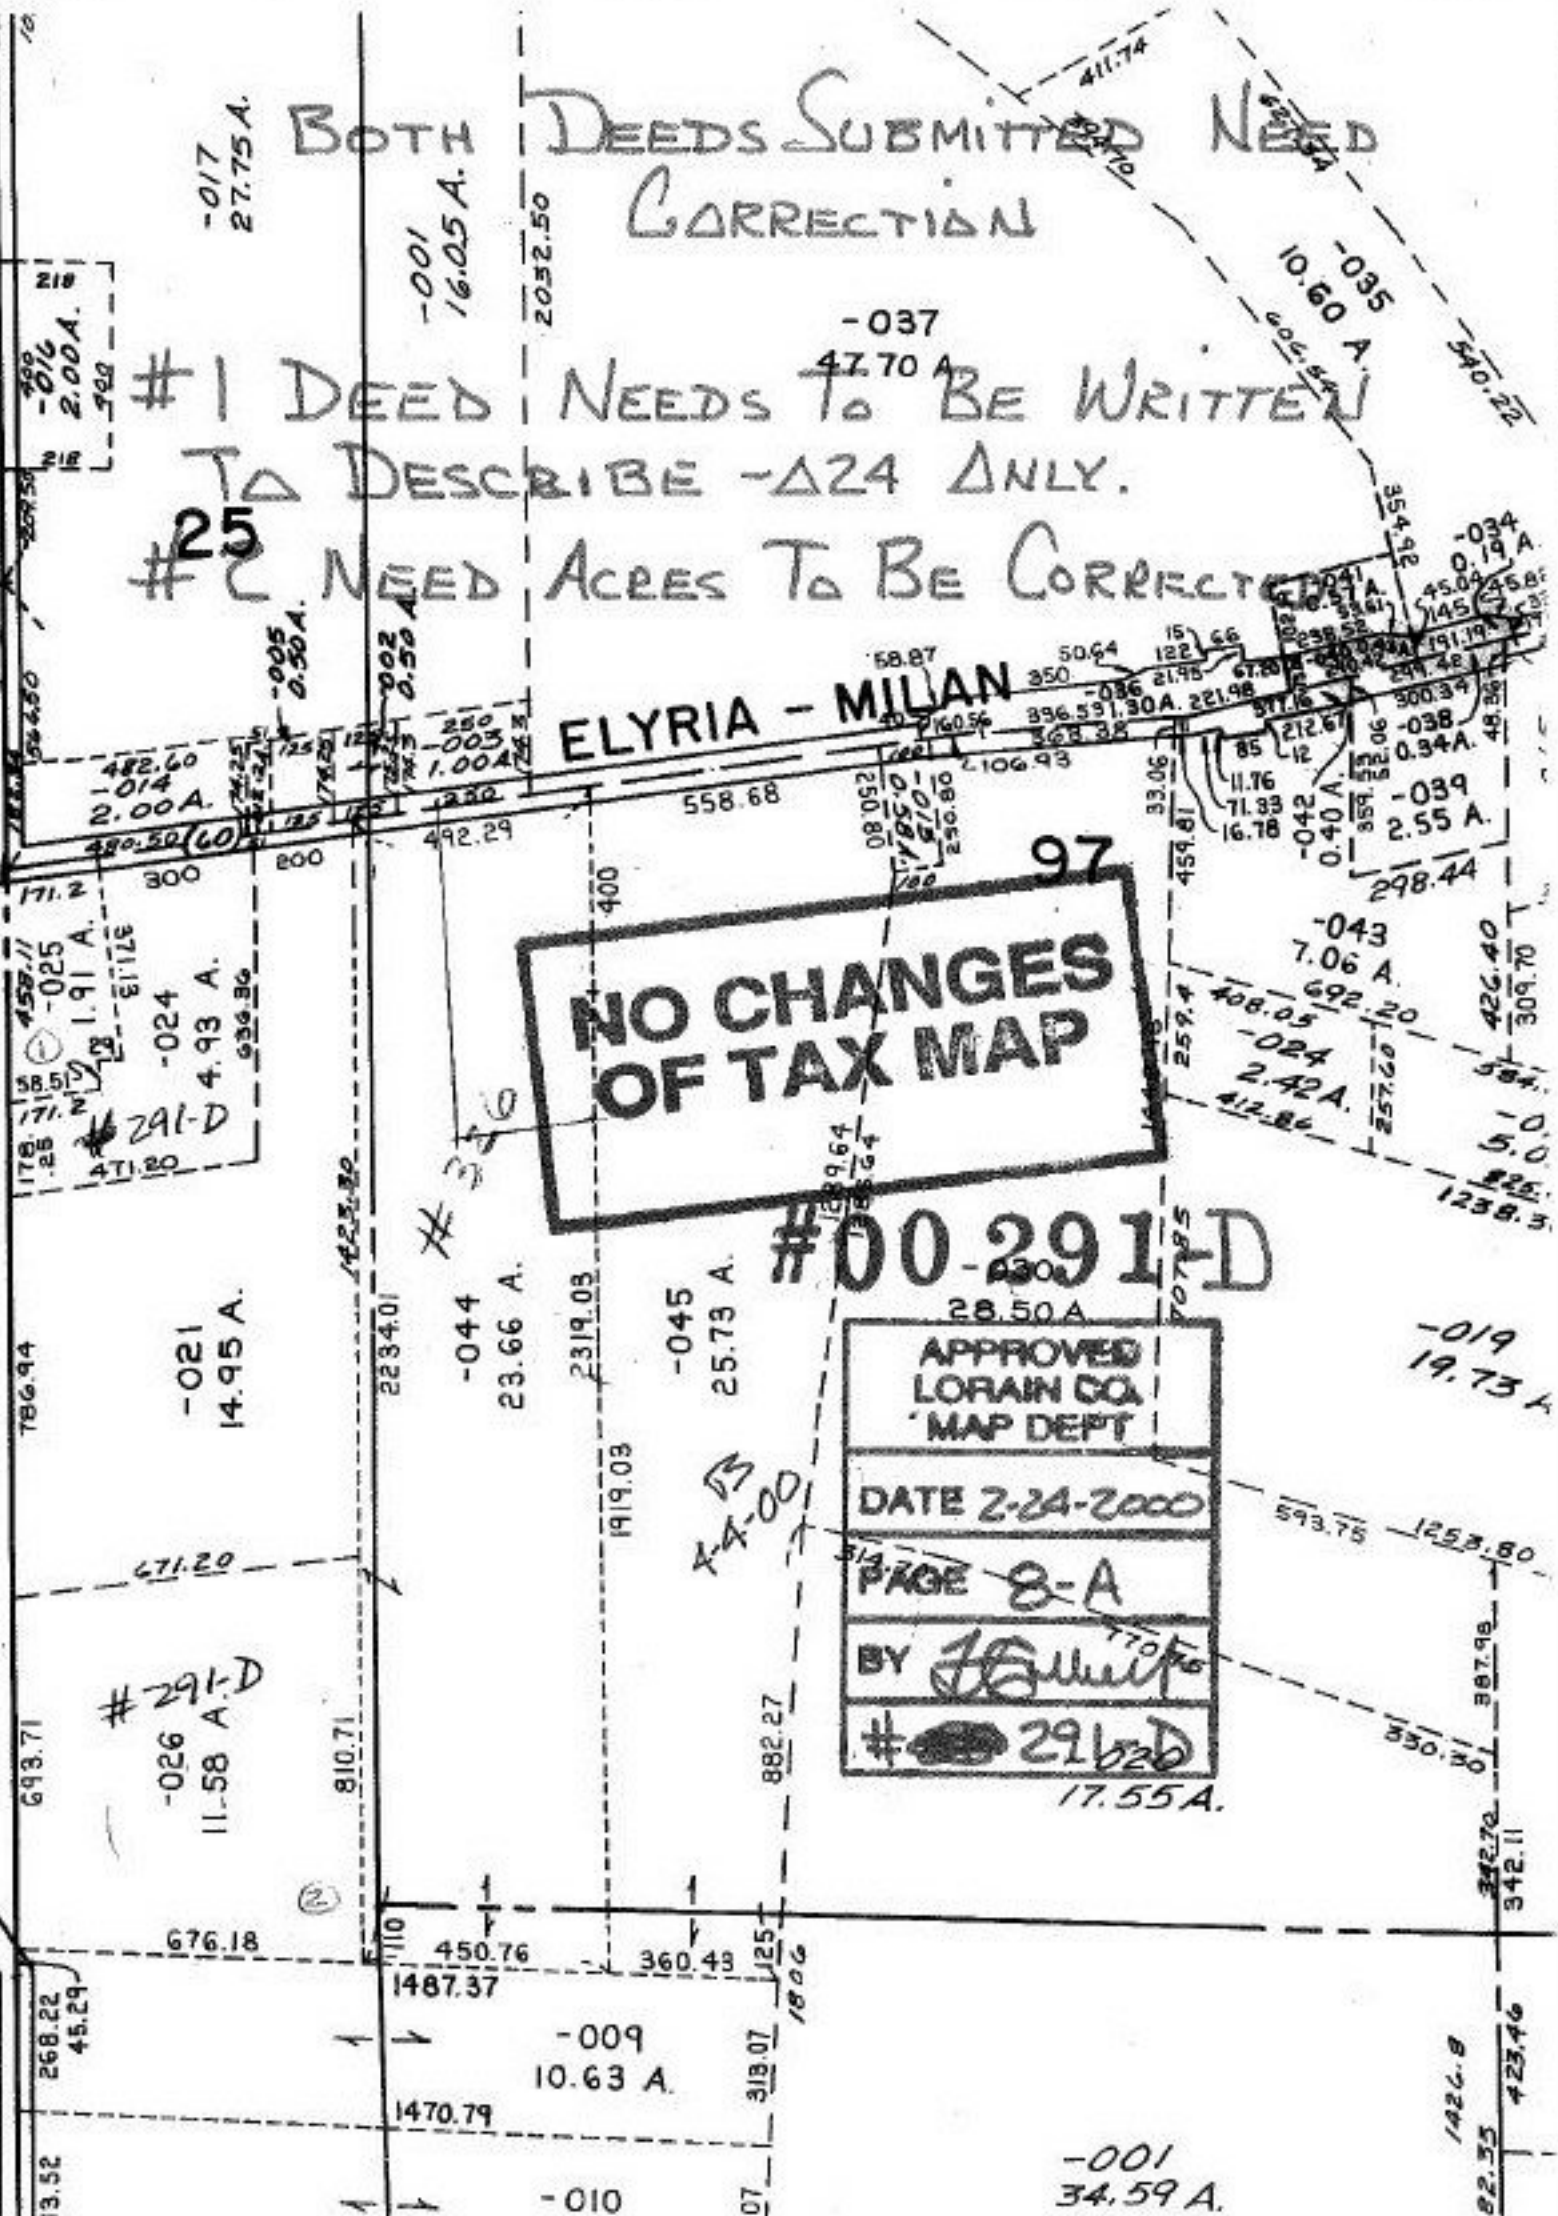

2.00 A.

0.50 A.

2.00 A.

1.91 A.

4.93 A.

14.95 A.

11.58 A.

10.63 A.

34.59 A.

16.05 A.

0.50 A.

0.50 A.

23.66 A.

25.73 A.

10.63 A.

10.63 A.

10.63 A.

34.59 A.

2052.50

58.87

558.68

2319.03

1919.03

882.27

450.76

360.43

319.07

47.70 A.

221.98

2106.93

28.50 A.

17.55 A.

17.55 A.

17.55 A.

17.55 A.

34.59 A.

411.74

354.32

330.06

459.61

259.4

593.75

1253.80

397.98

342.11

10.60 A.

0.19 A.

0.34 A.

2.55 A.

7.06 A.

2.42 A.

19.73 A.

19.73 A.

34.59 A.