


THIS DEED ALSO SUBMITTED UNDER
TICKET NUMBER 316-D

-001
105.70 A.

20

2-25-2000

A

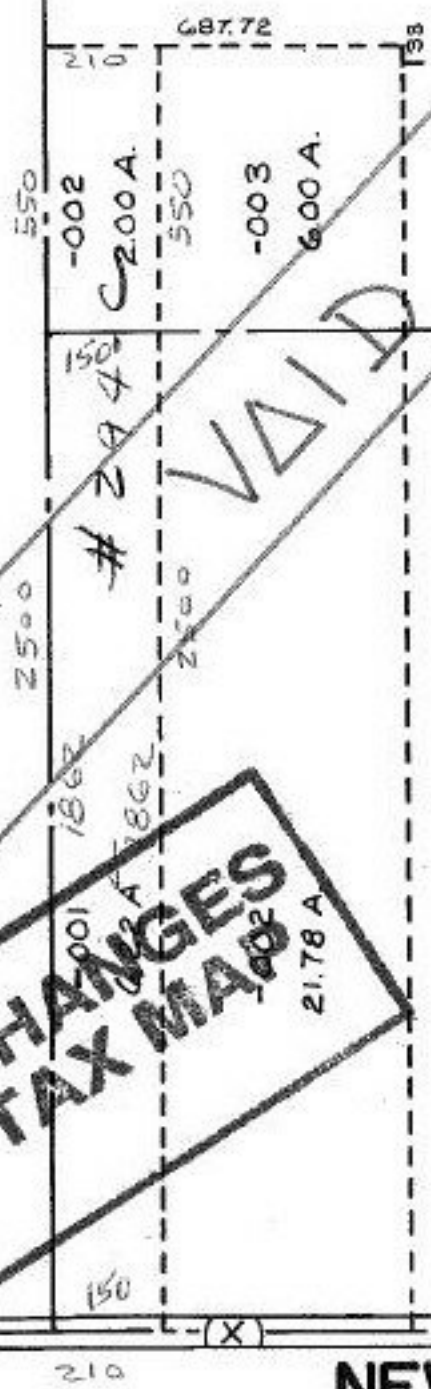

2678.28
2358.28

-006
37.80 A.

R

#00-00294-C
#00-00316-C

19

#00 294-D

-003
114.25 A.

**NO CHANGES
OF TAX MAPS**
21.78 A

APPROVED LORAIN CO. MAP DEPT
DATE
PAGE 20 - C
BY
294-D

TS
4-6-00



NEW LONDON - LAFAYETTE