

PARENT PARCEL: 03-00-045-102-065, & 03-00-031-101-009

CHILD PARCEL: XX-XX-XXX-XXX-XXX

STARTING POINT: MON. BOX, CL OF LAKE RD. & CL OF ROOT RD.

NO. 00295-D




ACREAGE CORR.

03-00-045-102-065
~~16.66 A.~~
15.71 A.

03-00-031-101-009
~~4.34 A.~~
4.15 A.
AC. CORR. PER SURV.
JOSEPH R. CIUNI

03-00-045-102-070
~~5.62 A.~~
5.60 A.
AC. CORR. PER SURV.
DOUGLAS P. McLAUGHLIN

AS
3-30-00

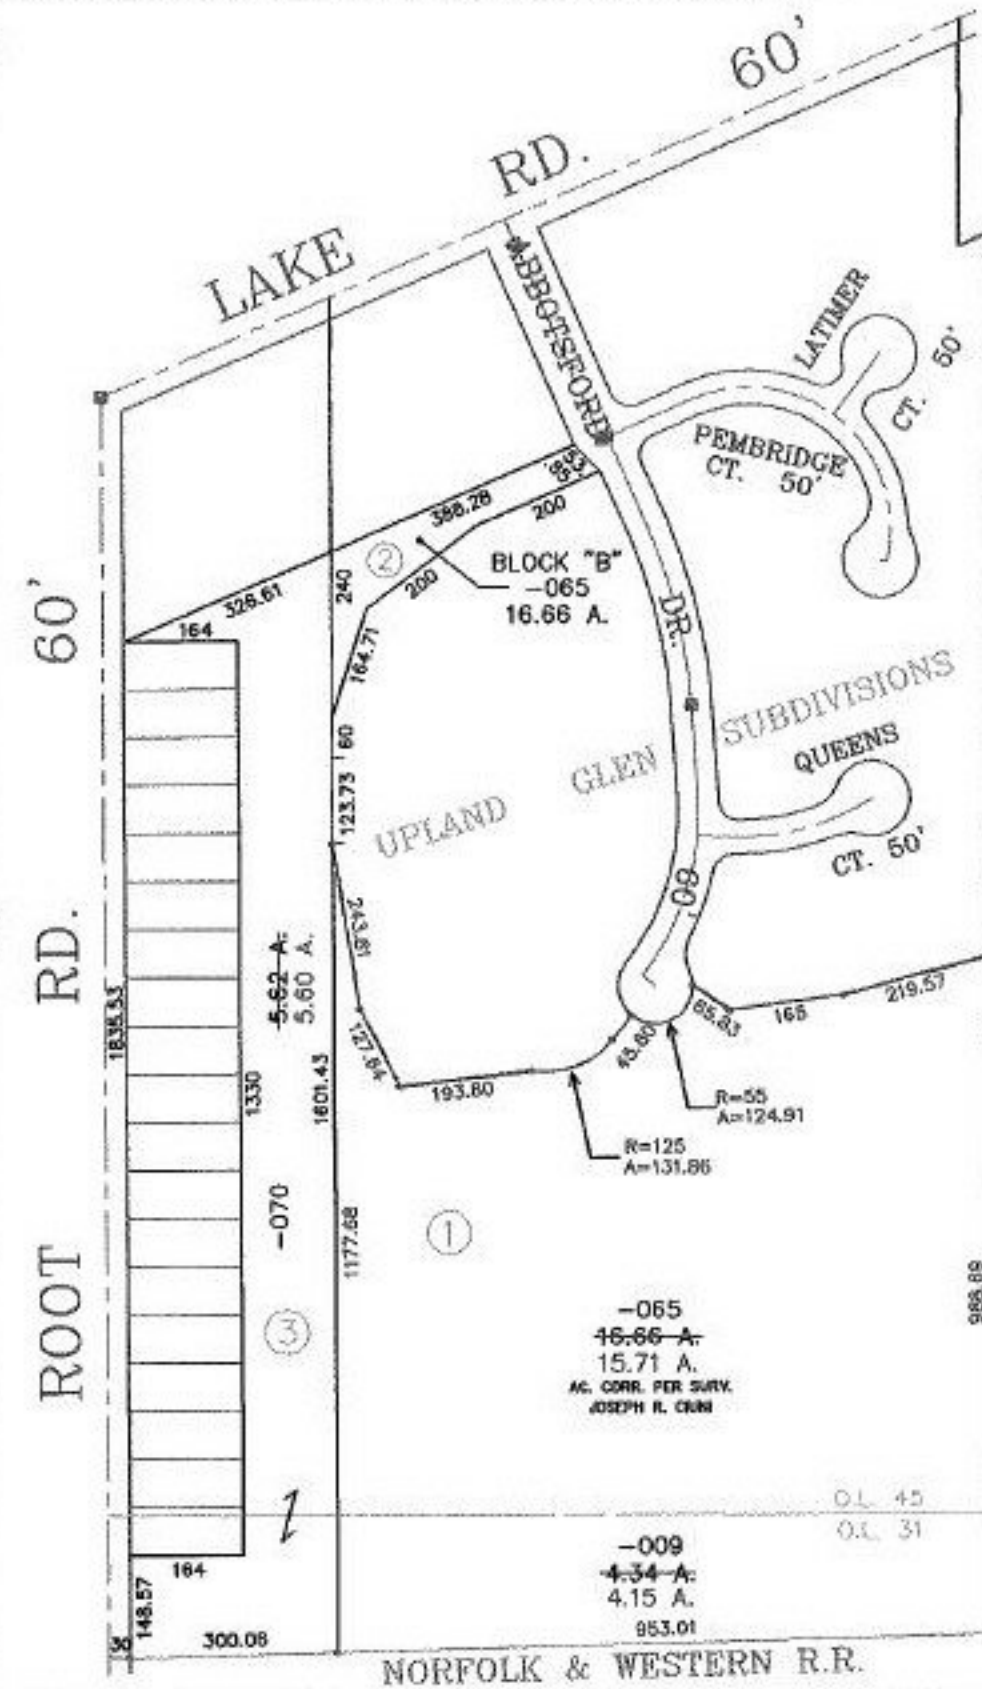

SPLITS/DEEDS PROCESSED
LORAIN COUNTY TAX MAP DEPARTMENT
226 MIDDLE AVE. ELYRIA, OHIO

SURVEYED BY: J. R. CIUNI & D. P. McLAUGHLIN
CLOSURE: 0.01 : 10,000
MAP PAGE(S): 03-00-045 & 03-00-031-A
APPROVED BY: I. SPILLMAN DATE: 02/09/00
SCALE: 1" = 300' PRIOR INSTRUMENT: DV XXXX/XXX