

PARENT PARCEL: 09-00-074-101-047


CHILD PARCEL: 09-00-074-101-049, 050

STARTING POINT: INT C.L. WEST LORAIN AND C.L. PYLE SOUTH AMHERST

NO. 00296



PYLE SOUTH AMHERST ROAD 60'

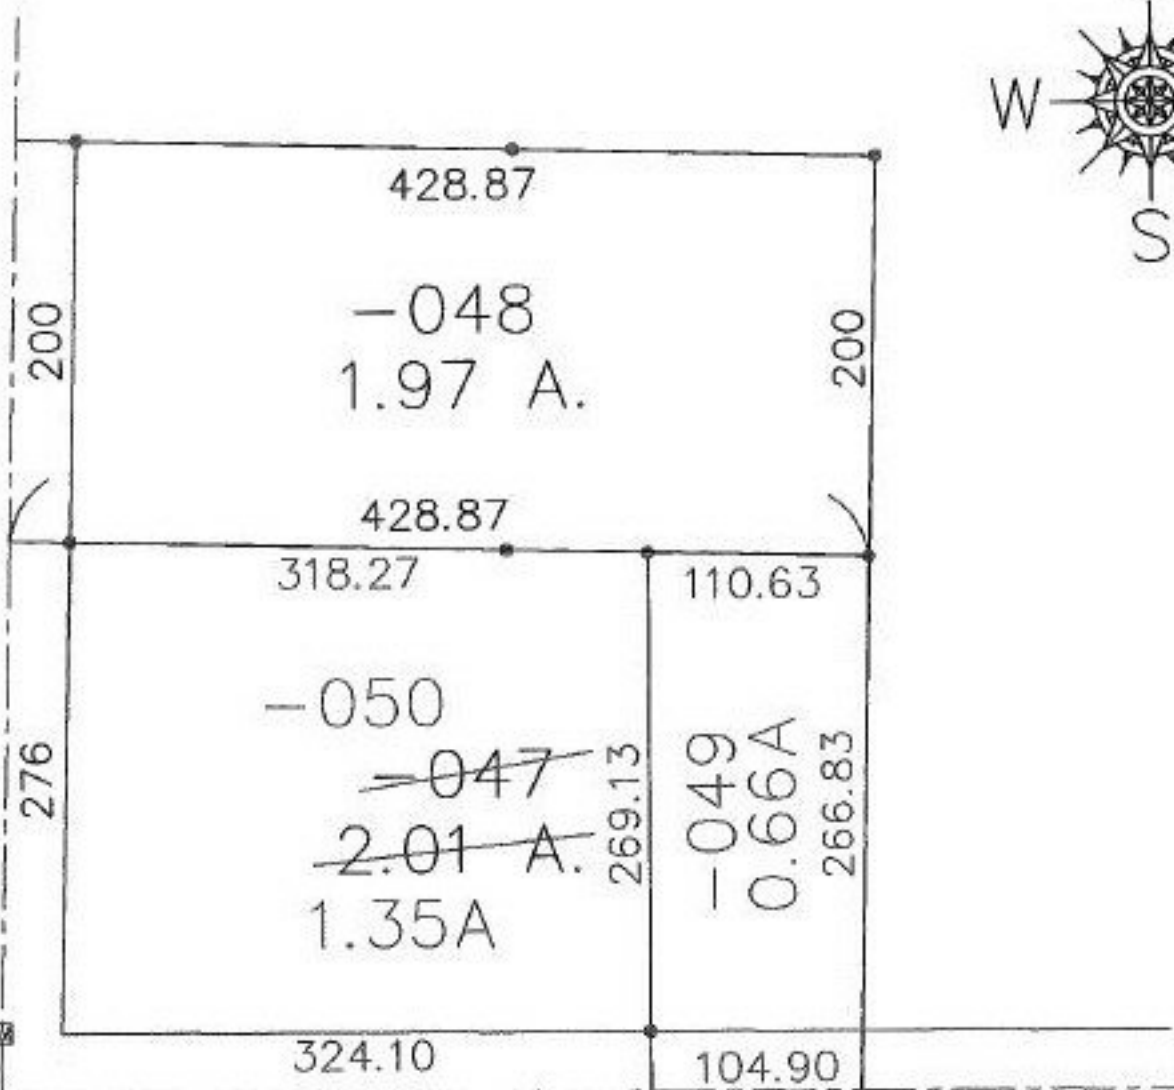

WEST LORAIN ST

TS
3-31-00



SPLITS/DEEDS PROCESSED

LORAIN COUNTY TAX MAP DEPARTMENT
226 MIDDLE AVE. ELYRIA, OHIO

SURVEYED BY: RODGER G. SIMON

CLOSURE: 0.06: 10,000

MAP PAGE(S): 09-00-074-A

APPROVED BY: F. COLBERT DATE: 12/13/99

SCALE: 1" = 100' PRIOR INSTRUMENT: #571072