

PARENT PARCEL: 05-00-057-000-263

CHILD PARCEL: NONE

STARTING POINT: NONE

NO. 00299-X



STREET NAME CHANGE

~~DEER RUN~~

STONE VALLEY DR.

RESOLUTION NO. 99-786

PASSED OCT. 7, 1999

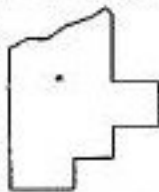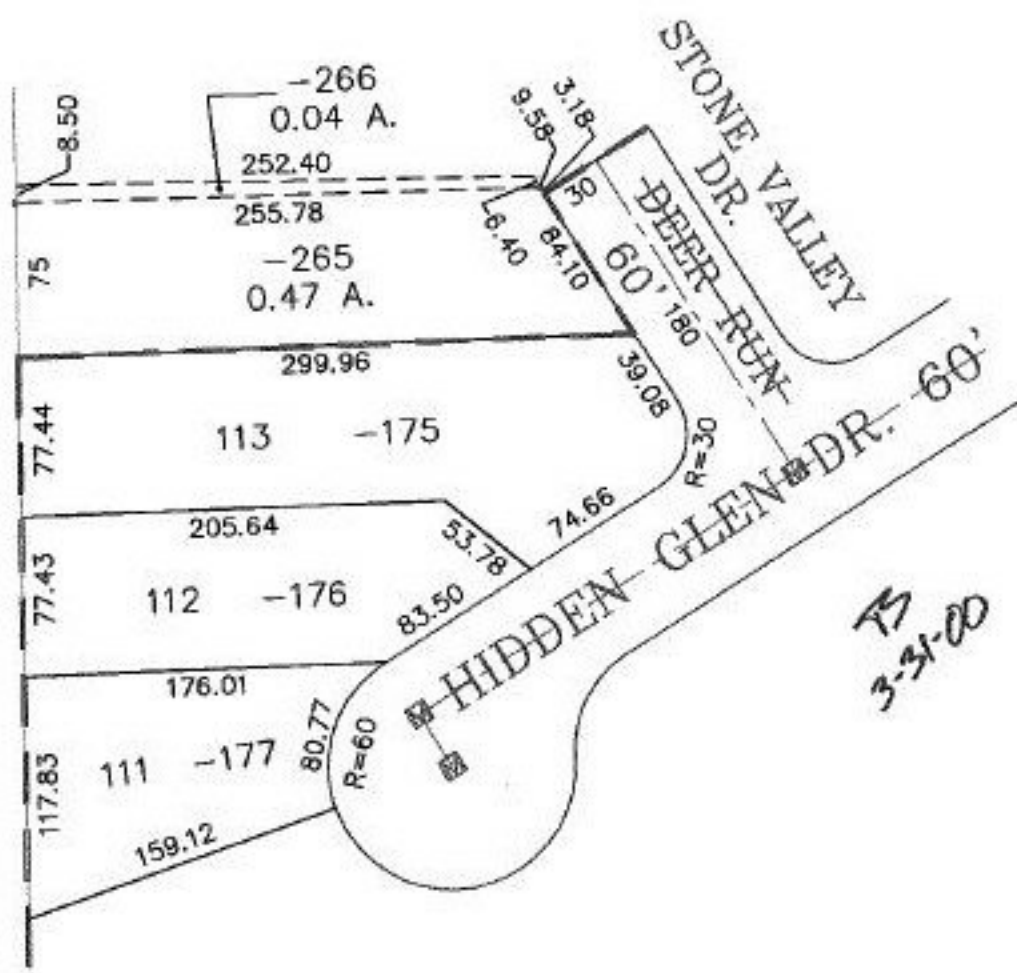

SPLITS/DEEDS PROCESSED

LORAIN COUNTY TAX MAP DEPARTMENT
226 MIDDLE AVE. ELYRIA, OHIO

SURVEYED BY: PATRICK A. MCGANNON

CLOSURE: NONE

MAP PAGE(S): 05-00-057-A

APPROVED BY: T. SPILLMAN DATE: 02/24/00

SCALE: 1" = 100' PRIOR INSTRUMENT: NONE