

PARENT PARCEL: 04-00-029-000-118


CHILD PARCEL: 04-00-029-000-327, 328

STARTING POINT: MON. BOX AT C/L TREESIDE LANE & S. LINE WALKER ROAD.

NO. 00306



WALKER ROAD

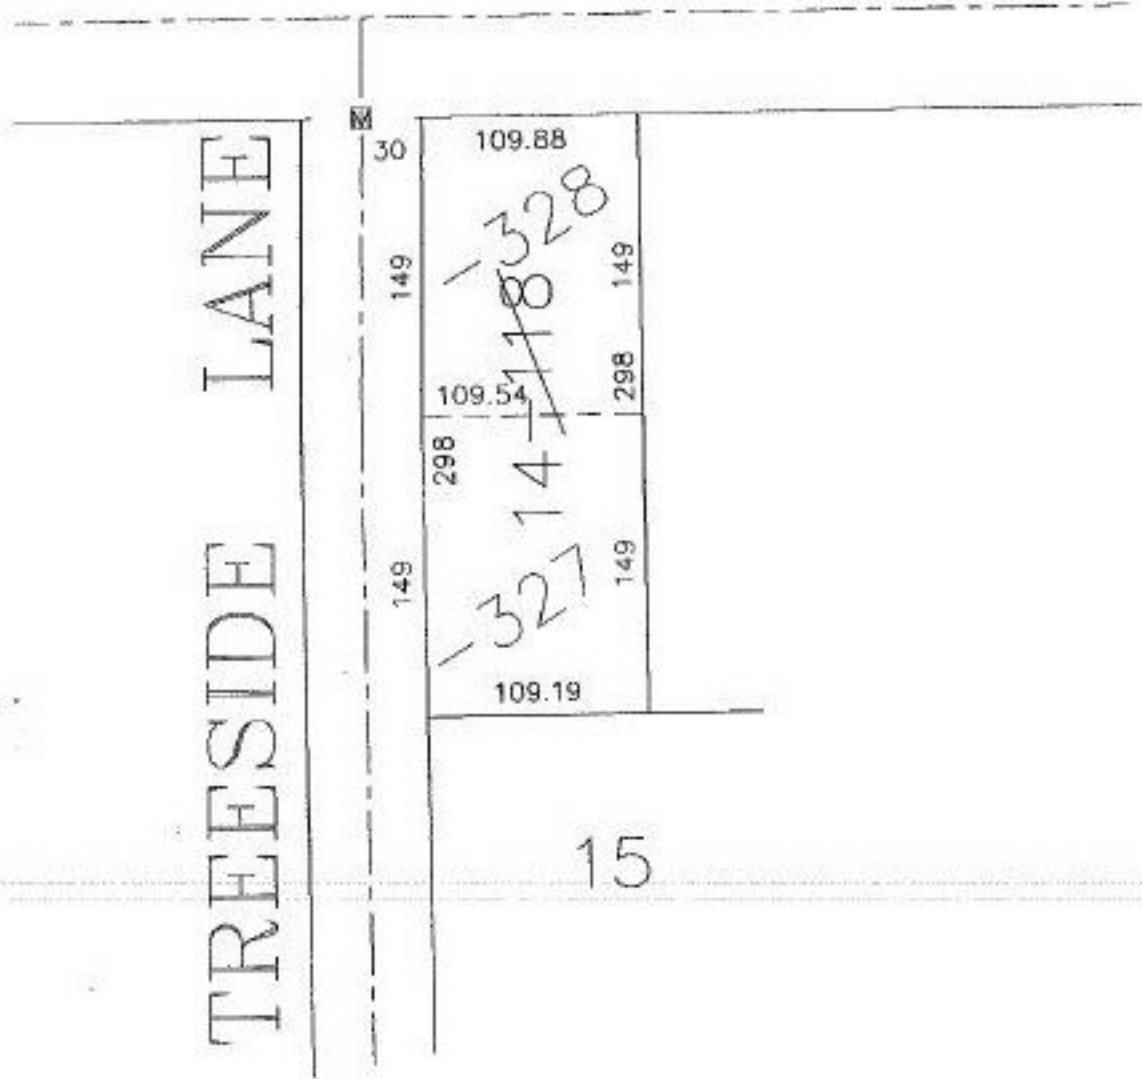

SPLITS/DEEDS PROCESSED

LORAIN COUNTY TAX MAP DEPARTMENT
226 MIDDLE AVE. ELYRIA, OHIO

SURVEYED BY: MICHAEL A STRAUB

CLOSURE: 0.13 / 10,000

MAP PAGE(S): 4-D (29)

APPROVED BY: F. COLBERT DATE: 12/29/99

SCALE: 1" = 100' PRIOR INSTRUMENT: 980518974