


PARENT PARCEL: 03-00-011-102-053, 072, 087, 103

NO. 00307

CHILD PARCEL: 03-00-011-102-104, 105

STARTING POINT: C/L ABBE ROAD & S. LINE O.L. 11

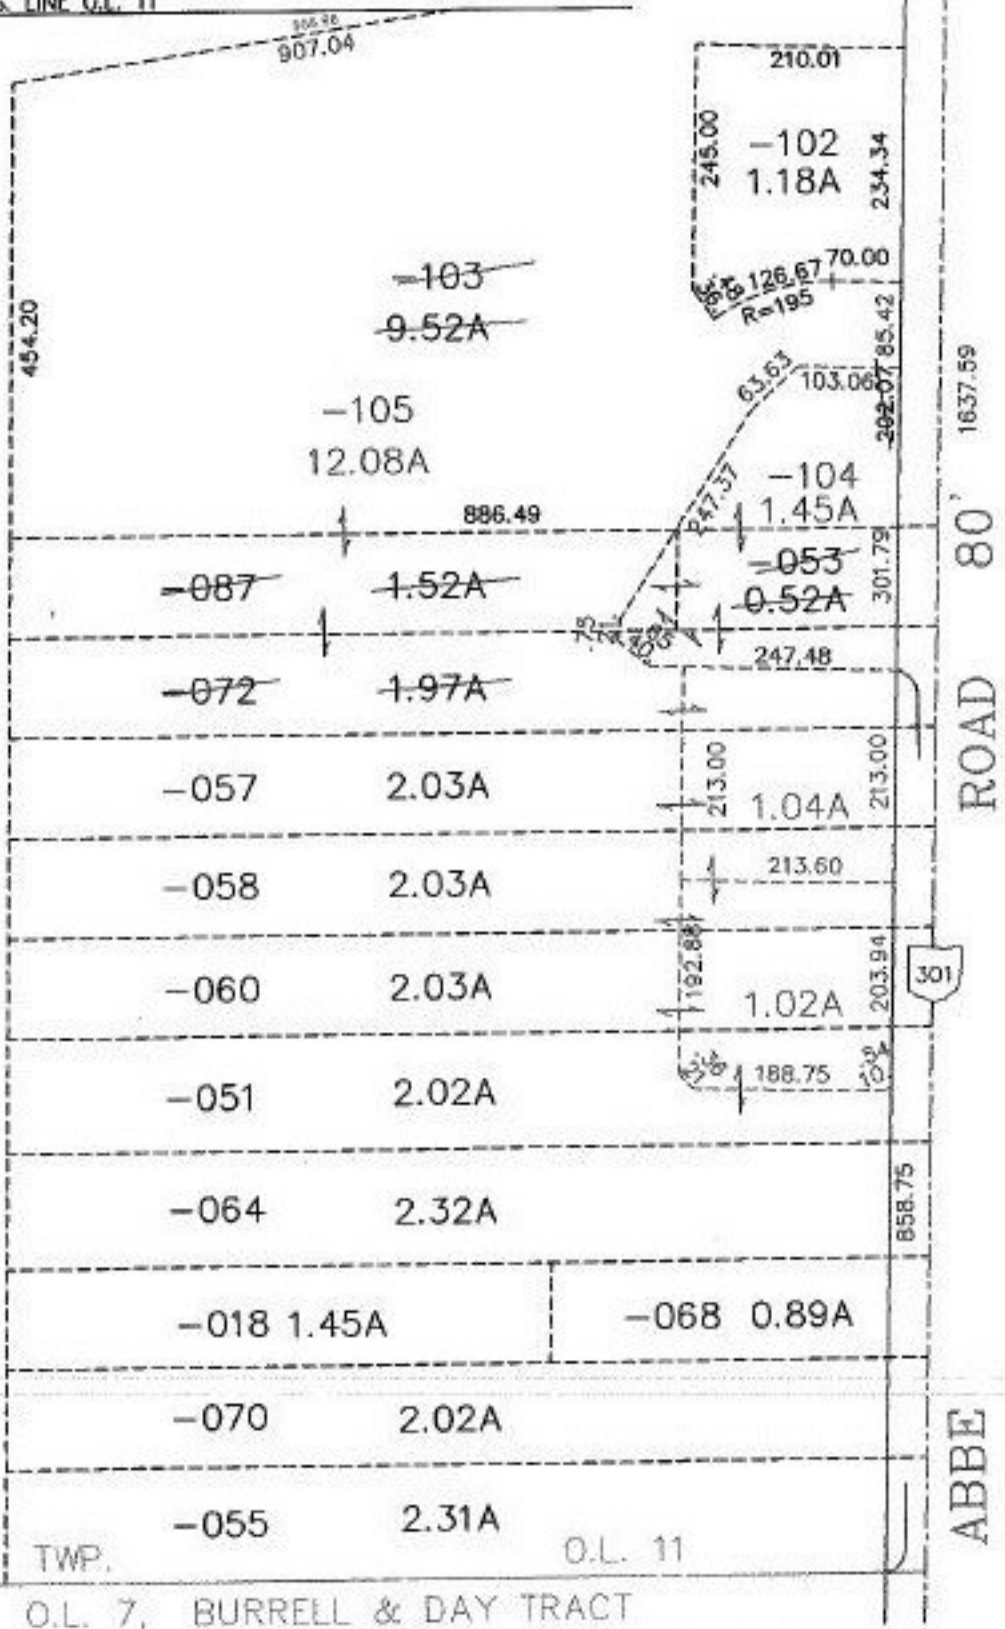

FUTURE SPLITS

13
3-30-00

-029
27.64A

ROAD 80' 1637.59
301
ABBE

2292.28 SHEFFIELD TWP. O.L. 11
ELYRIA TWP. O.L. 7, BURRELL & DAY TRACT



SPLITS/DEEDS PROCESSED
RAIN COUNTY TAX MAP DEPARTMENT
226 MIDDLE AVE. ELYRIA, OHIO

SURVEYED BY: DONALD E. WOIKE
CLOSURE: 0.05 / 10.000
MAP PAGE(S): 3-00-011-B
APPROVED BY: F. COLBERT DATE: 12/15/99
SCALE: 1" = 200' PRIOR INSTRUMENT: 980573046