


PARENT PARCEL: 06-25-006-110-017

CHILD PARCEL: 06-25-006-110-018, 019

STARTING POINT: C/Ls OF BROAD STREET & ABBE ROAD

NO. 00309

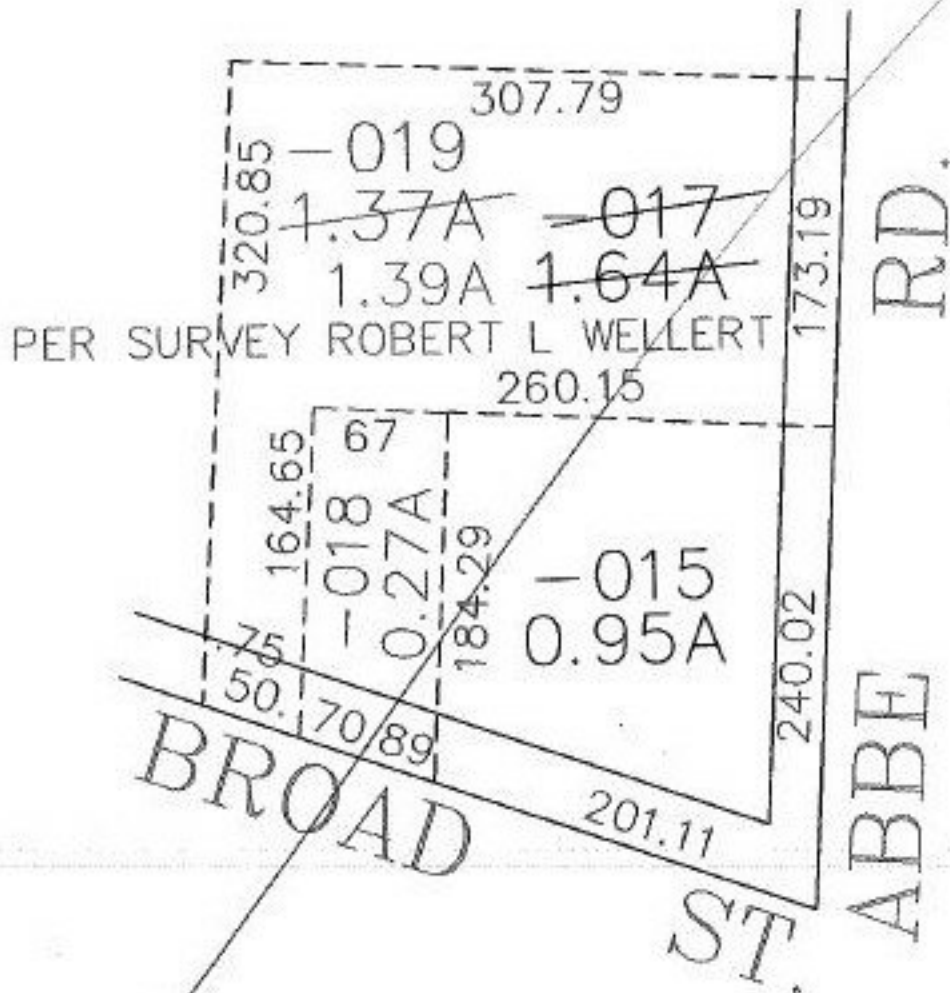

SPLITS/DEEDS PROCESSED

LORAIN COUNTY TAX MAP DEPARTMENT
226 MIDDLE AVE. ELYRIA, OHIO

SURVEYED BY: ROBERT L WELLET

CLOSURE: 0.03 / 10,000

MAP PAGE(S): 6-124

APPROVED BY: F. COLBERT DATE: 12/21/99

SCALE: 1" = 100' PRIOR INSTRUMENT: 1044/815