


PARENT PARCEL: 12-00-059-000-012

CHILD PARCEL: XX-XX-XXX-XXX-XXX

STARTING POINT: R.R.S., CL OF OSBORNE RD. & CL OF JAQUAY RD.

NO. 00315-D

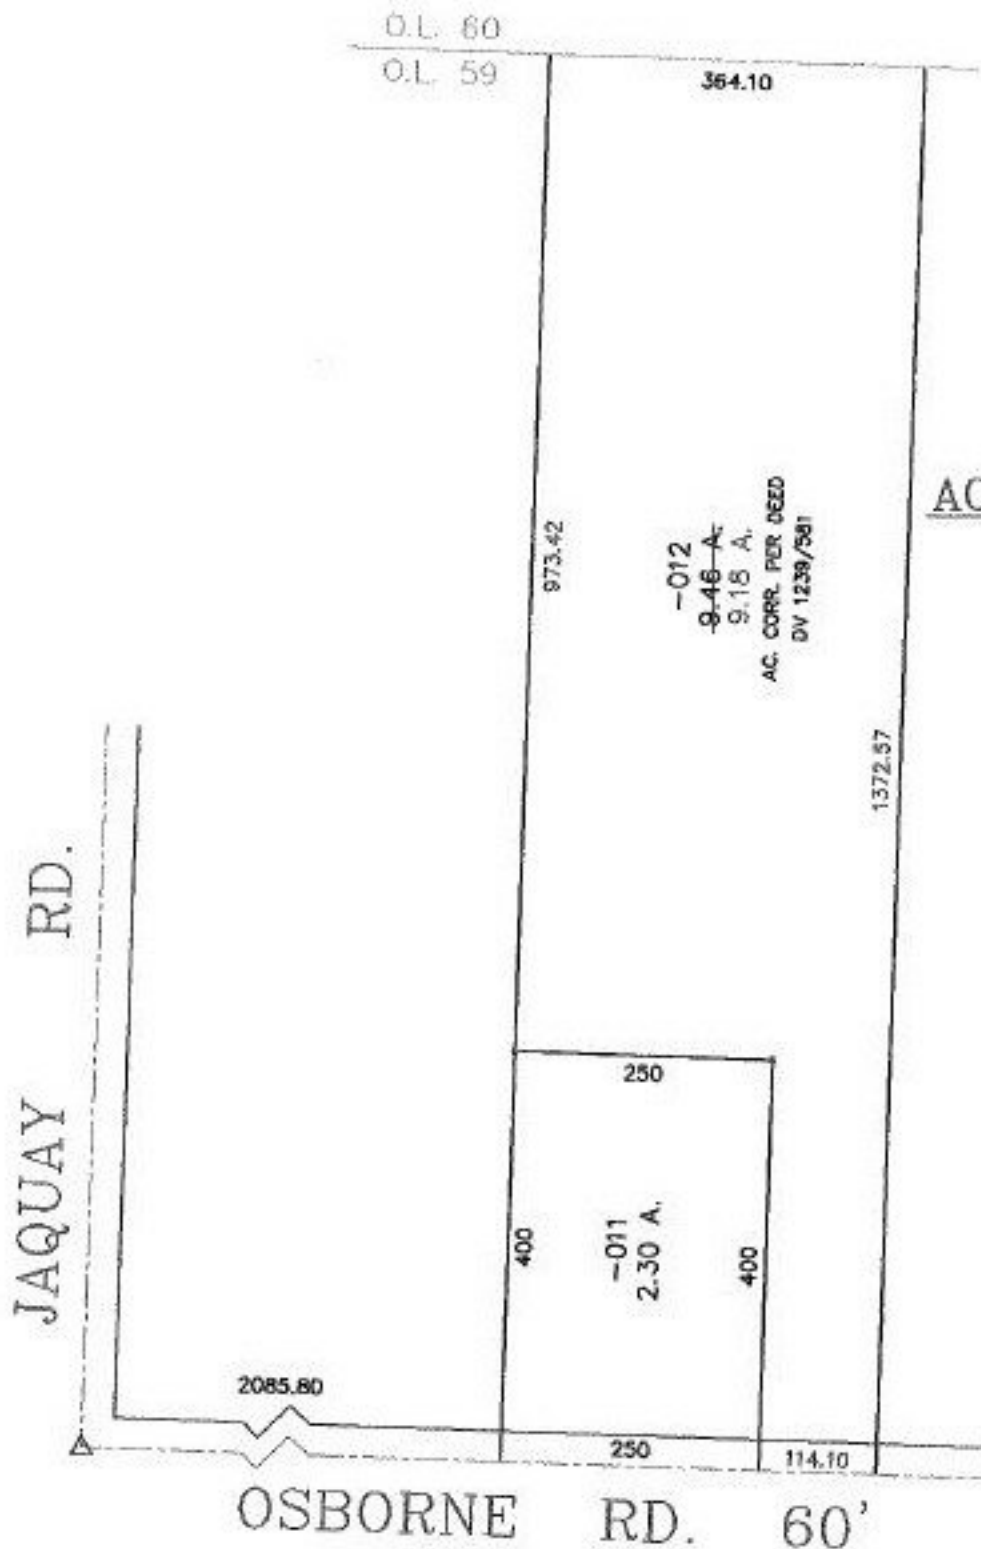

ACREAGE CORRECTION

12-00-059-000-012

~~9.46 A.~~

9.18 A.

AC. CORR. PER DEED

DV 1239/581



SPLITS/DEEDS PROCESSED
LORAIN COUNTY TAX MAP DEPARTMENT
226 MIDDLE AVE. ELYRIA, OHIO

| | |
|--------------|--|
| SURVEYED BY: | NONE |
| CLOSURE: | 0.01 : 10,000 |
| MAP PAGE(S): | 12-B |
| APPROVED BY: | T. SPILLMAN DATE: 02/28/00 |
| SCALE: | 1" = 200' PRIOR INSTRUMENT: DV 330/395 |