


**NO CHANGES  
OF TAX MAP**

-001  
105.70 A. 20

2-25-2000

THIS  $\nabla$  DEED  
CHECK ALSO SUBMITTED  
UNDER TICKET No. 294-D

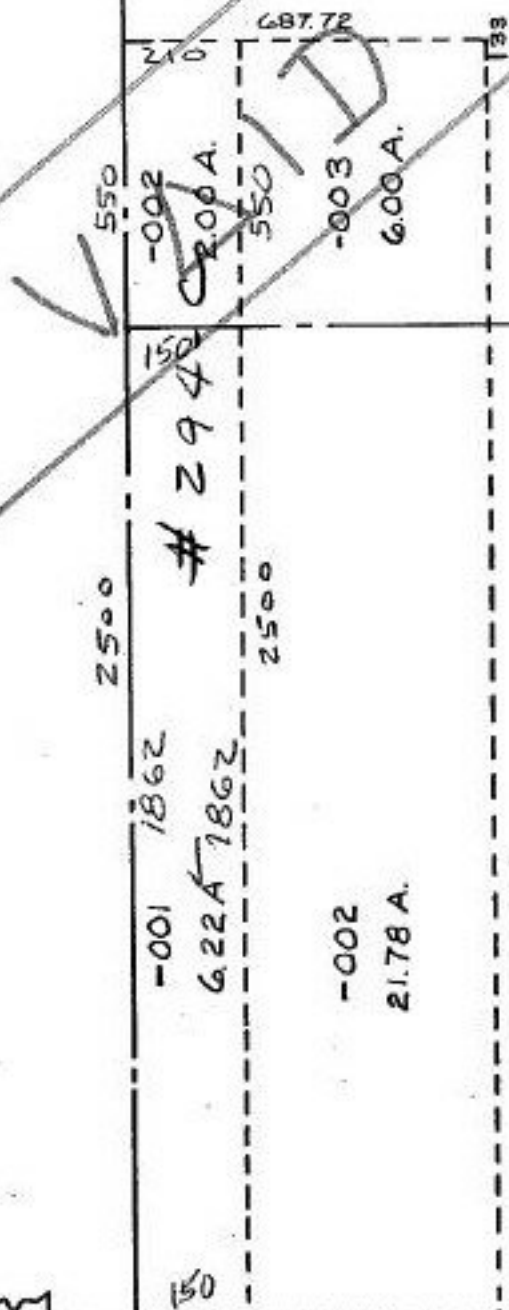

-006  
37.80A.

R

#00-06294-C  
#00-00316-C

19  
#00 316-D -003  
114.25A.

APPROVED LORAIN CO. MAP DEPT
DATE
PAGE 20-C
BY
# 316-D

TS  
A-6-00

162

NEW LONDON - LAFAYETTE