


SEE 12-A

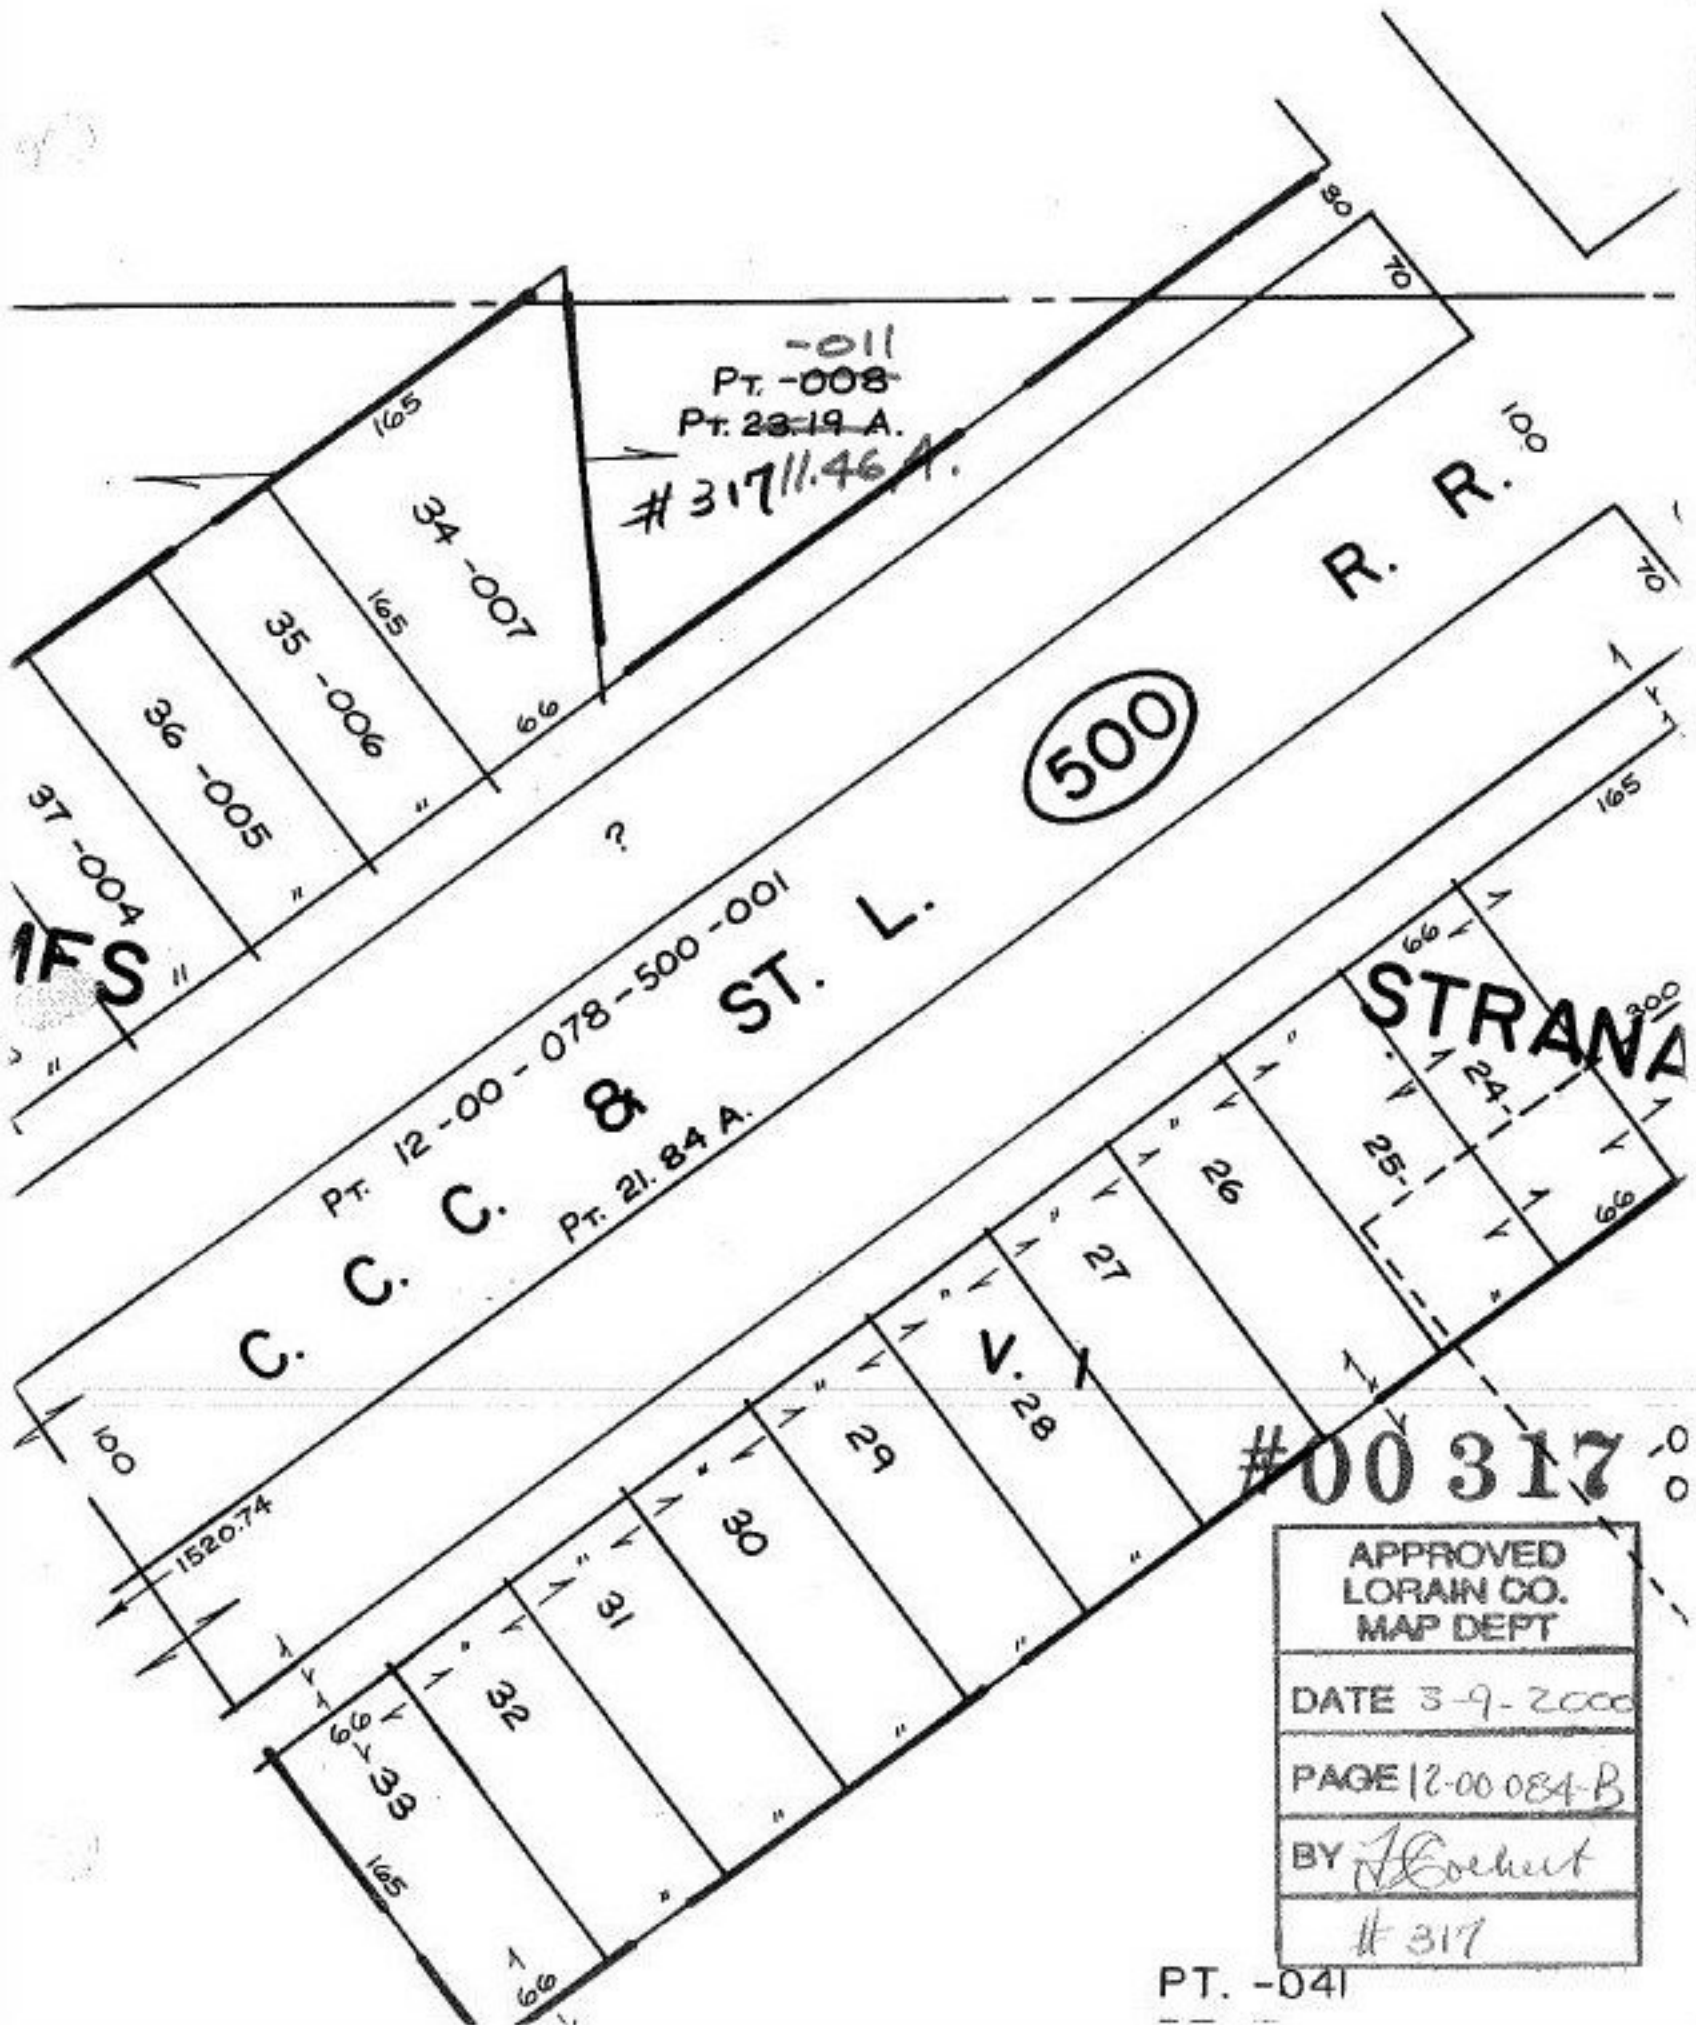

APPROVED LORAIN CO. MAP DEPT
DATE 3-9-2000
PAGE 12-00 084-B
BY <i>J. Coehnt</i>
317

PT. -041