

PARENT PARCEL: 01-00-004-108-006, 007, 008, 013, 014, 015  
 CHILD PARCEL: 01-00-004-108-006, 008, 013, 015, 028, 029, 030, 031  
 STARTING POINT: \_\_\_\_\_


NO. 00321

2-7-00  
 AM



WOODSIDE DR.

LORAIN DR.

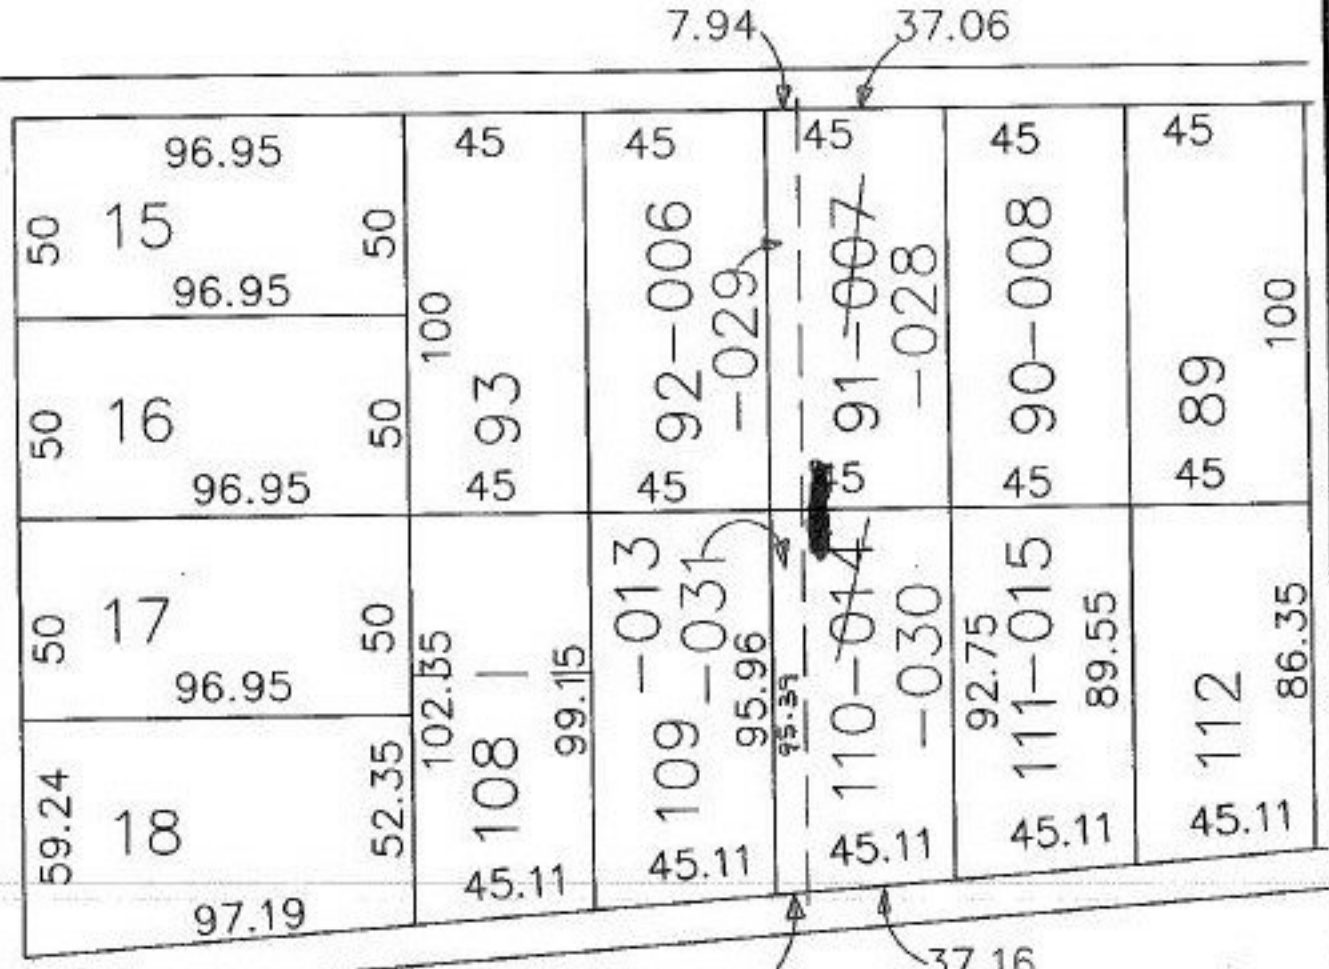

AMHERST DR.

3-29-00  
 DR.



**SPLITS/DEEDS PROCESSED**  
 LORAIN COUNTY TAX MAP DEPARTMENT  
 226 MIDDLE AVE. ELYRIA, OHIO

SURVEYED BY: MIKE HURR  
 CLOSURE: \_\_\_\_\_  
 MAP PAGE(S): 1-00-004-A  
 APPROVED BY: E. COLBERT DATE: 1/24/2000  
 SCALE: 1" = 50' PRIOR INSTRUMENT: 1273/80