

PARENT PARCEL: 19-01-022-000-003

CHILD PARCEL: XX-XX-XXX-XXX-XXX


STARTING POINT: XXXXXX

NO. 00324-X

MAP CORRECTION ONLY



S.R. 301

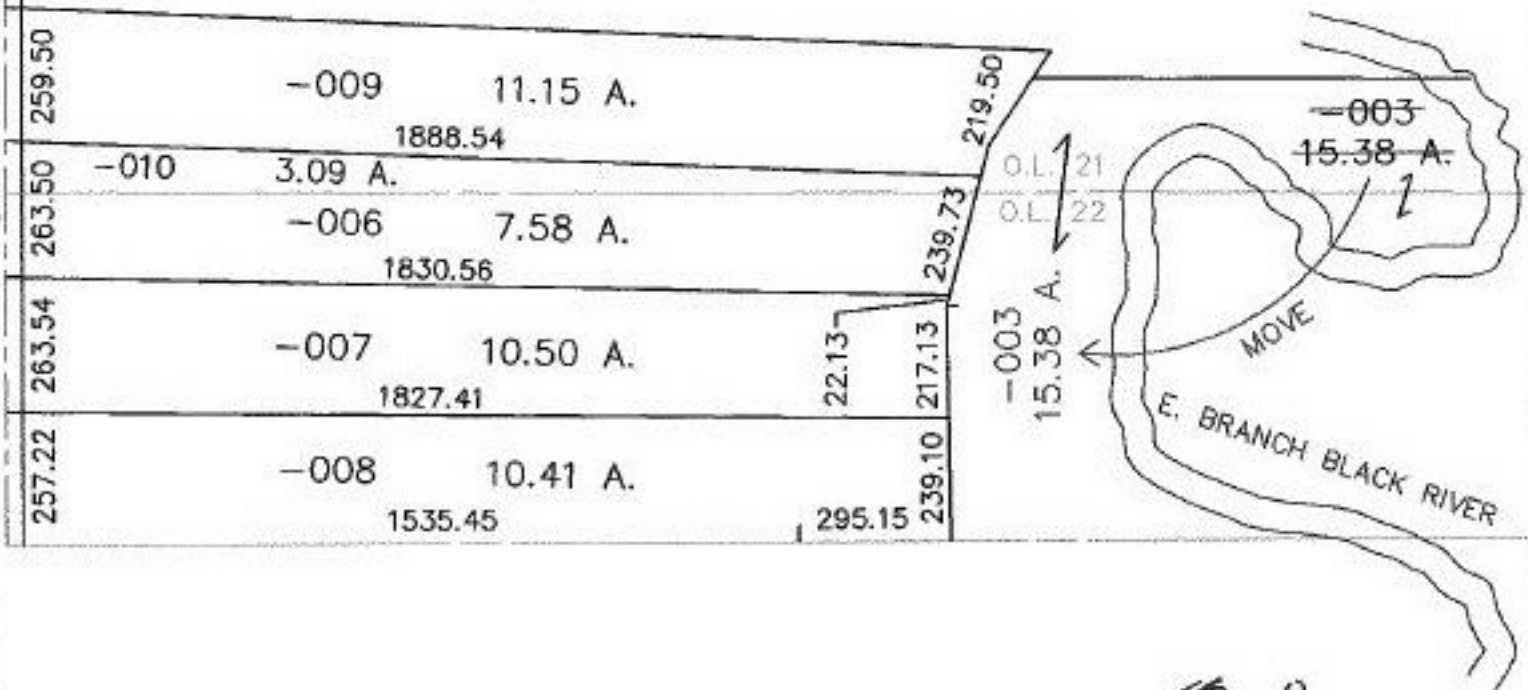

TS
A-6-00



SPLITS/DEEDS PROCESSED
LORAIN COUNTY TAX MAP DEPARTMENT
 226 MIDDLE AVE. ELYRIA, OHIO

SURVEYED BY: NONE
 CLOSURE: NONE
 MAP PAGE(S): 19-F
 APPROVED BY: I. SPILLMAN DATE: 03/07/00
 SCALE: 1" = 400' PRIOR INSTRUMENT: NONE