

PARENT PARCEL: 19-02-030-000-036

CHILD PARCEL: XX-XX-XXX-XXX-XXX


STARTING POINT: XXXXXX

NO. 00325-X

PARCEL NUMBER CORRECTION

~~19-02-030-000-086~~

19-02-030-000-036

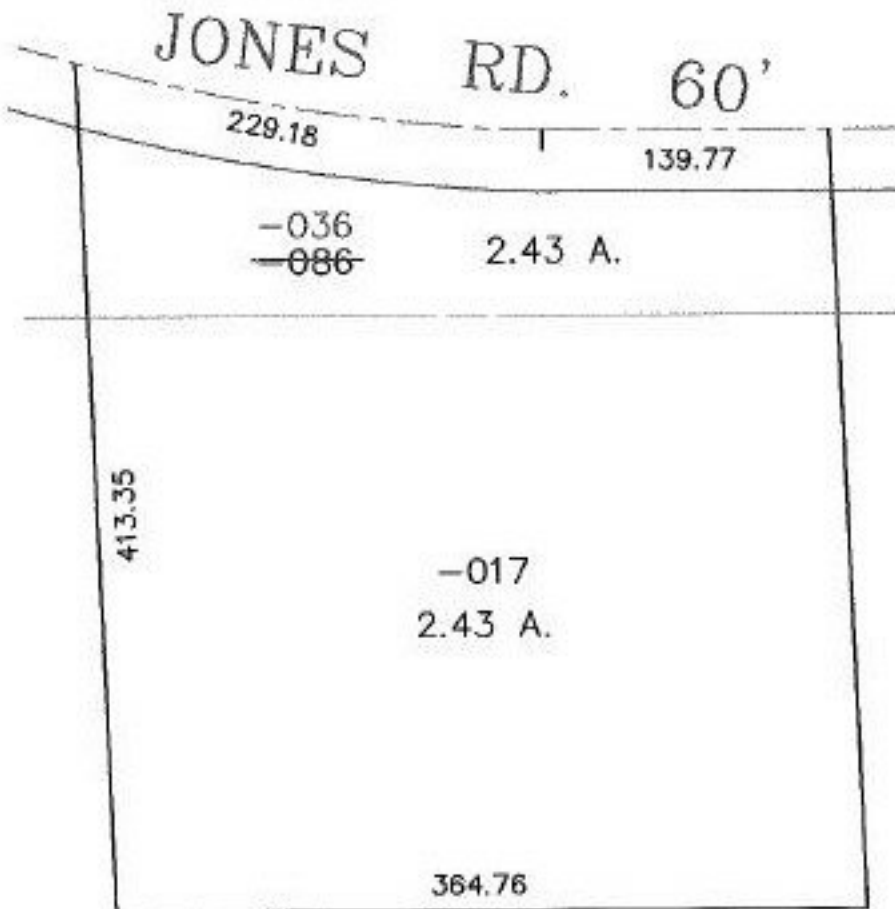

TS
4-6-00



SPLITS/DEEDS PROCESSED

LORAIN COUNTY TAX MAP DEPARTMENT
226 MIDDLE AVE. ELYRIA, OHIO

SURVEYED BY: NONE

CLOSURE: NONE

MAP PAGE(S): 19-G

APPROVED BY: T. SPILLMAN DATE: 03/09/00

SCALE: 1" = 100' PRIOR INSTRUMENT: NONE