


#00 327

APPROVED LORAIN CO. MAP DEPT
DATE 1-27-2060
PAGE 7-07-023-D
BY <i>H. Holbert</i>
#00-00327

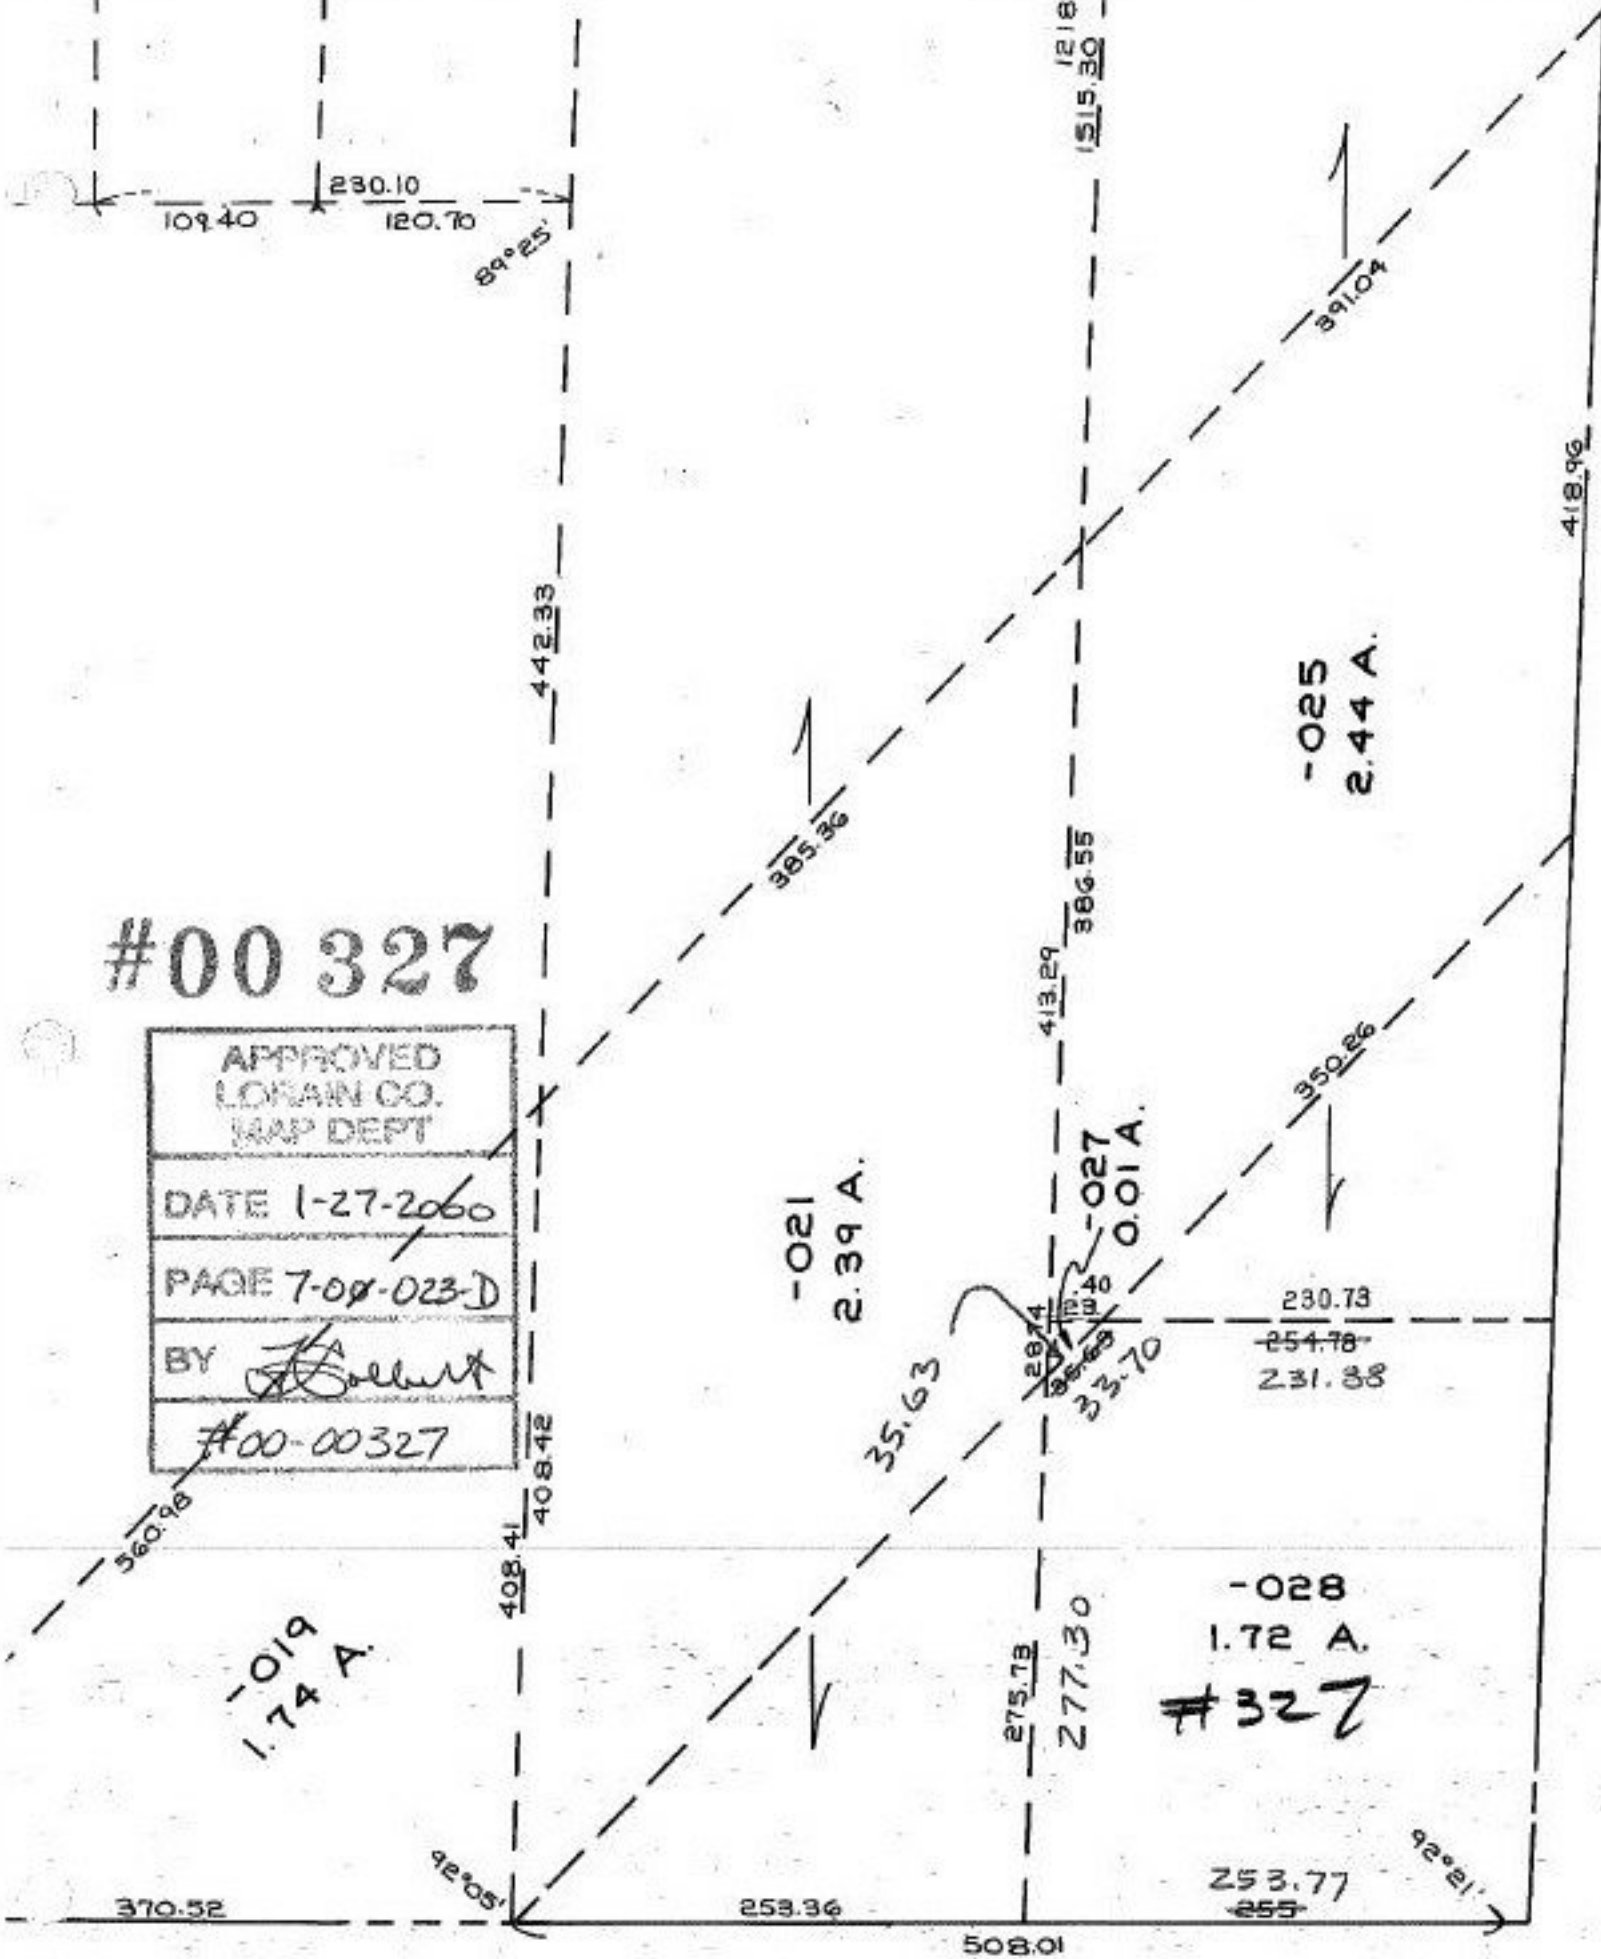

-B

7-00-023-D