


20-c

-001
105.70 A.

20

A

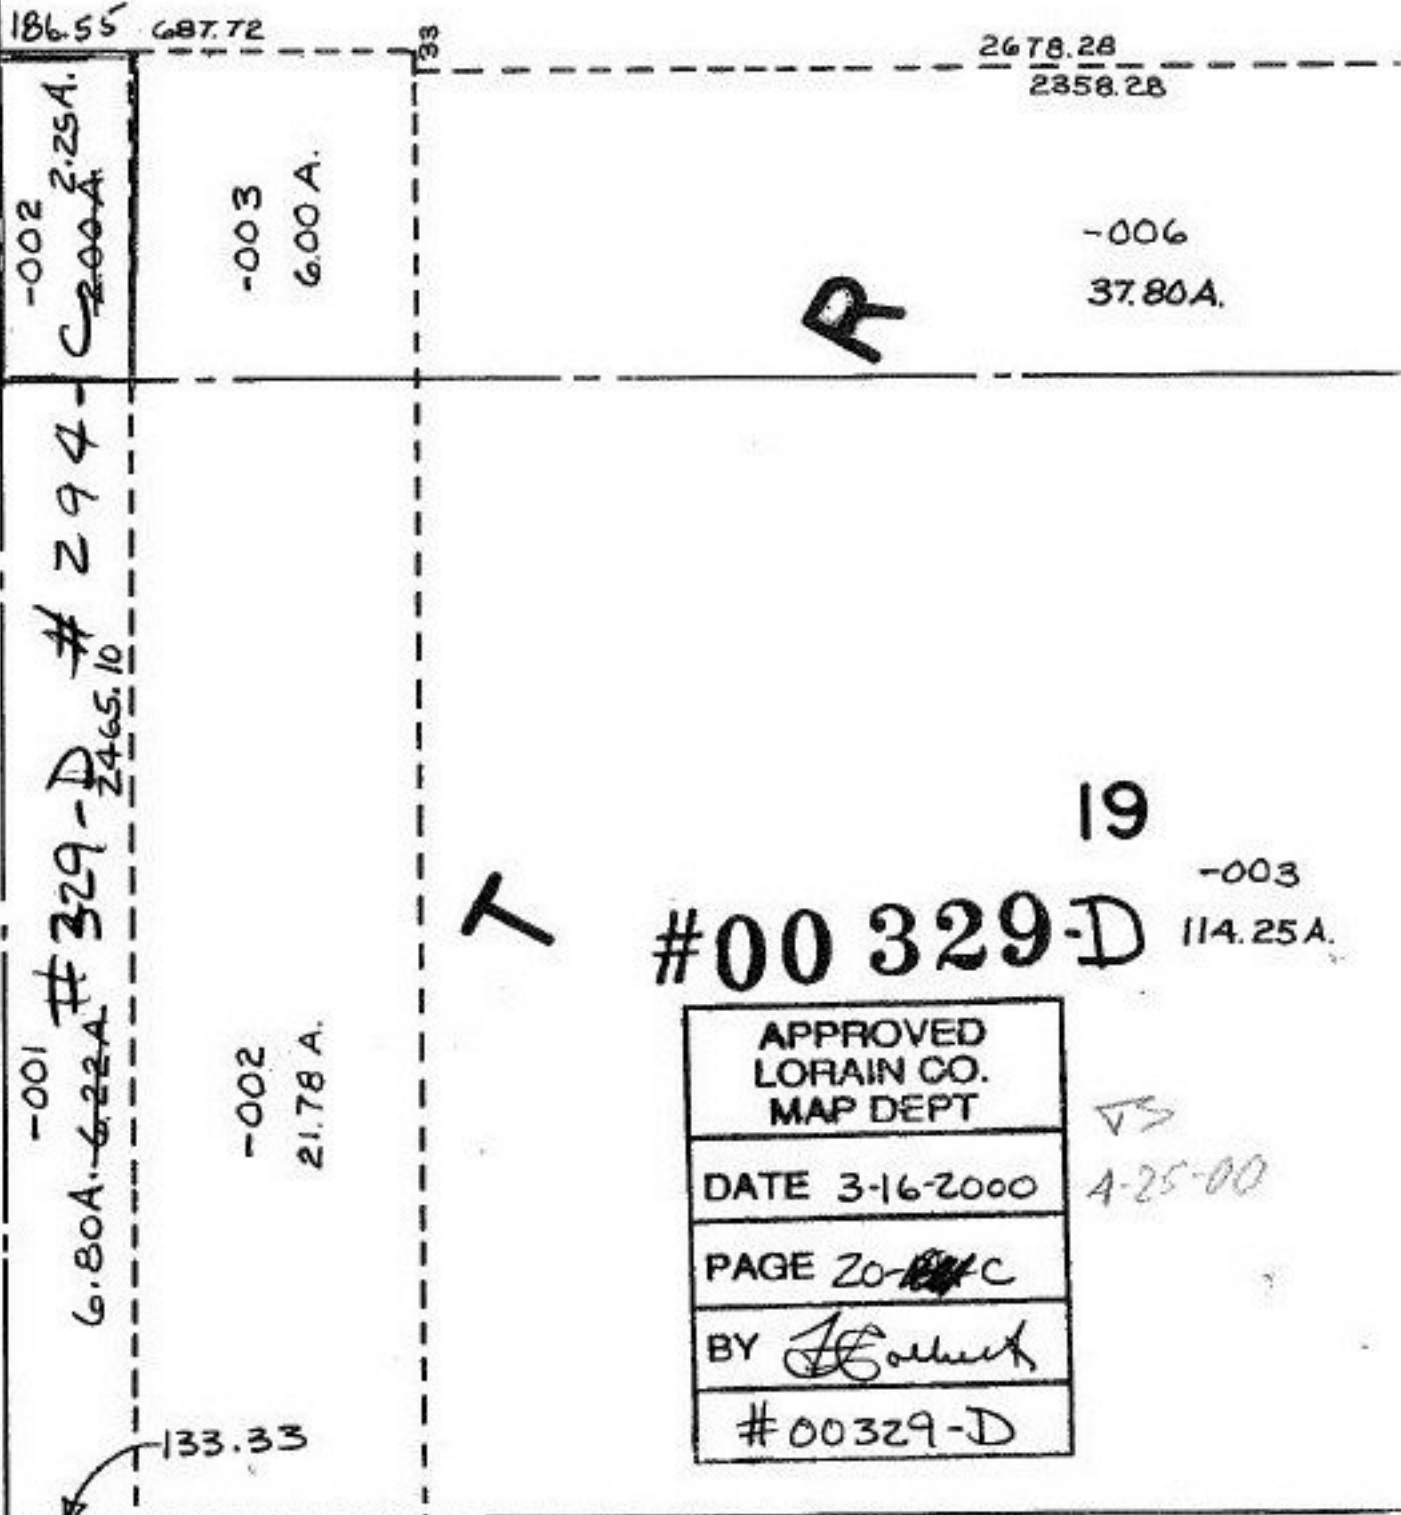

R

T

19

#00 329-D

APPROVED LORAIN CO. MAP DEPT
DATE 3-16-2000
PAGE 20- 18 C
BY <i>J. Colbeck</i>
#00329-D

VS
4-25-00



NEW LONDON - LAFAYETT