

12

1480


- 054
~~- 052~~
42.53 A.
~~43.68 A.~~

34 # 00 341

1250

APPROVED LORAIN CO. MAP DEPT
DATE 1-31-2000
PAGE 17-C
BY <i>F. Gilbert</i>
341

↖
425.00

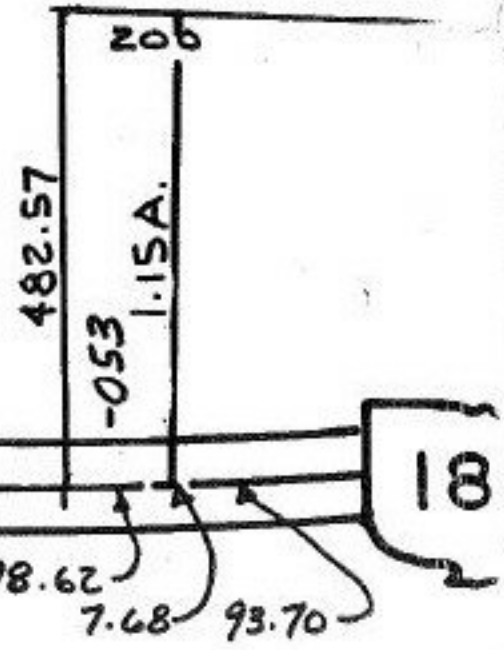

1500

(90)

RD.

18

98.62
7.68
93.70

8c