


Pt. 2.

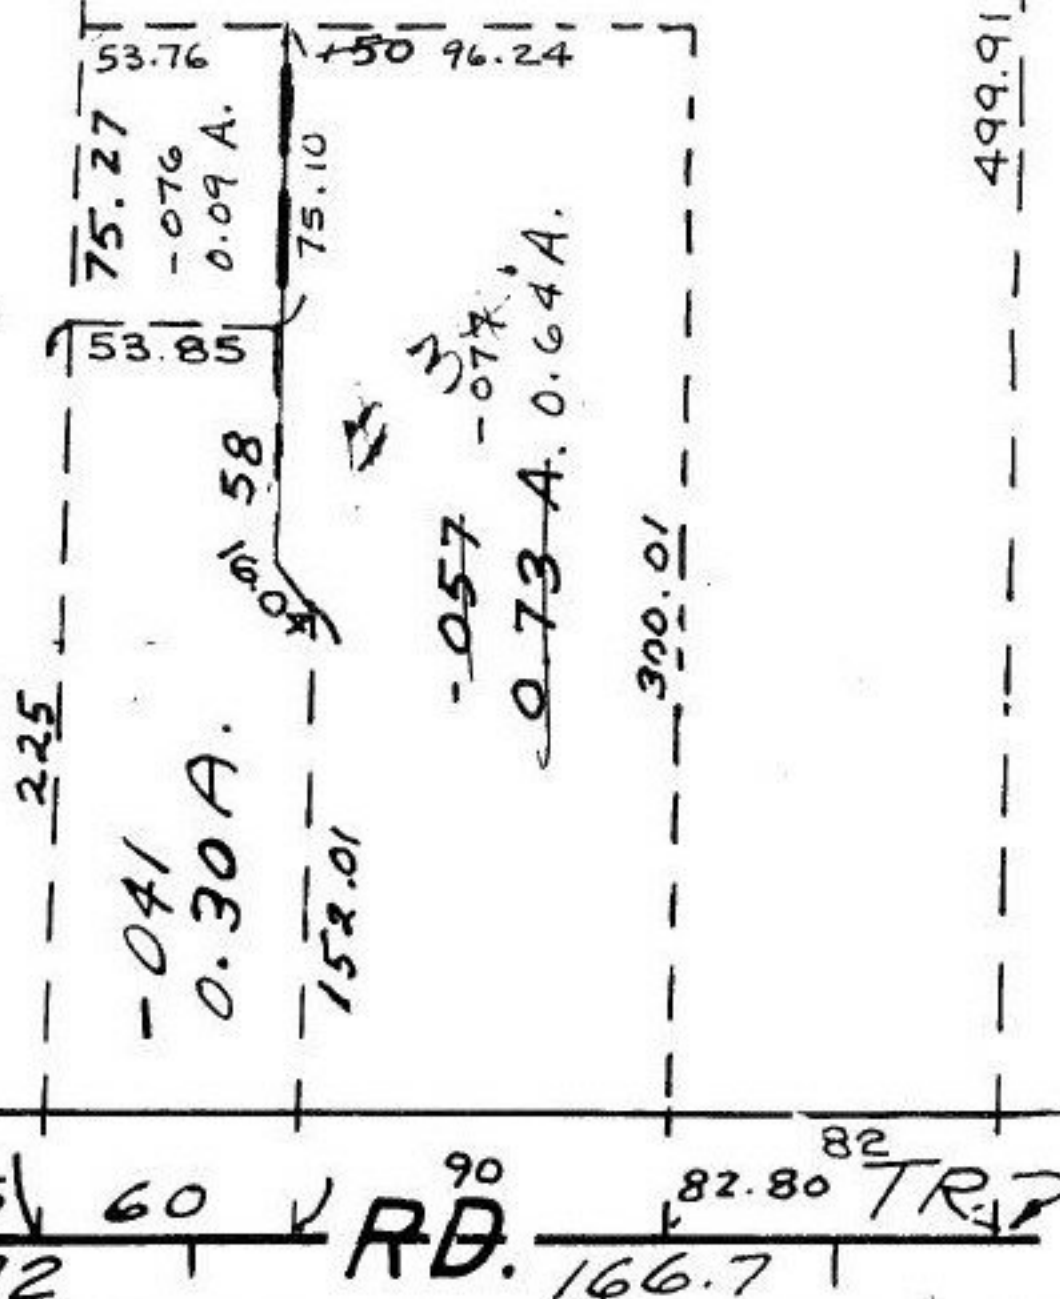

#00 346

APPROVED LORAIN CO. MAP DEPT
DATE 3-13-2000
PAGE 6-41
BY <i>H. L. L...</i>
#00346