


SEE 7-00-021-

JA

CENTERLINE

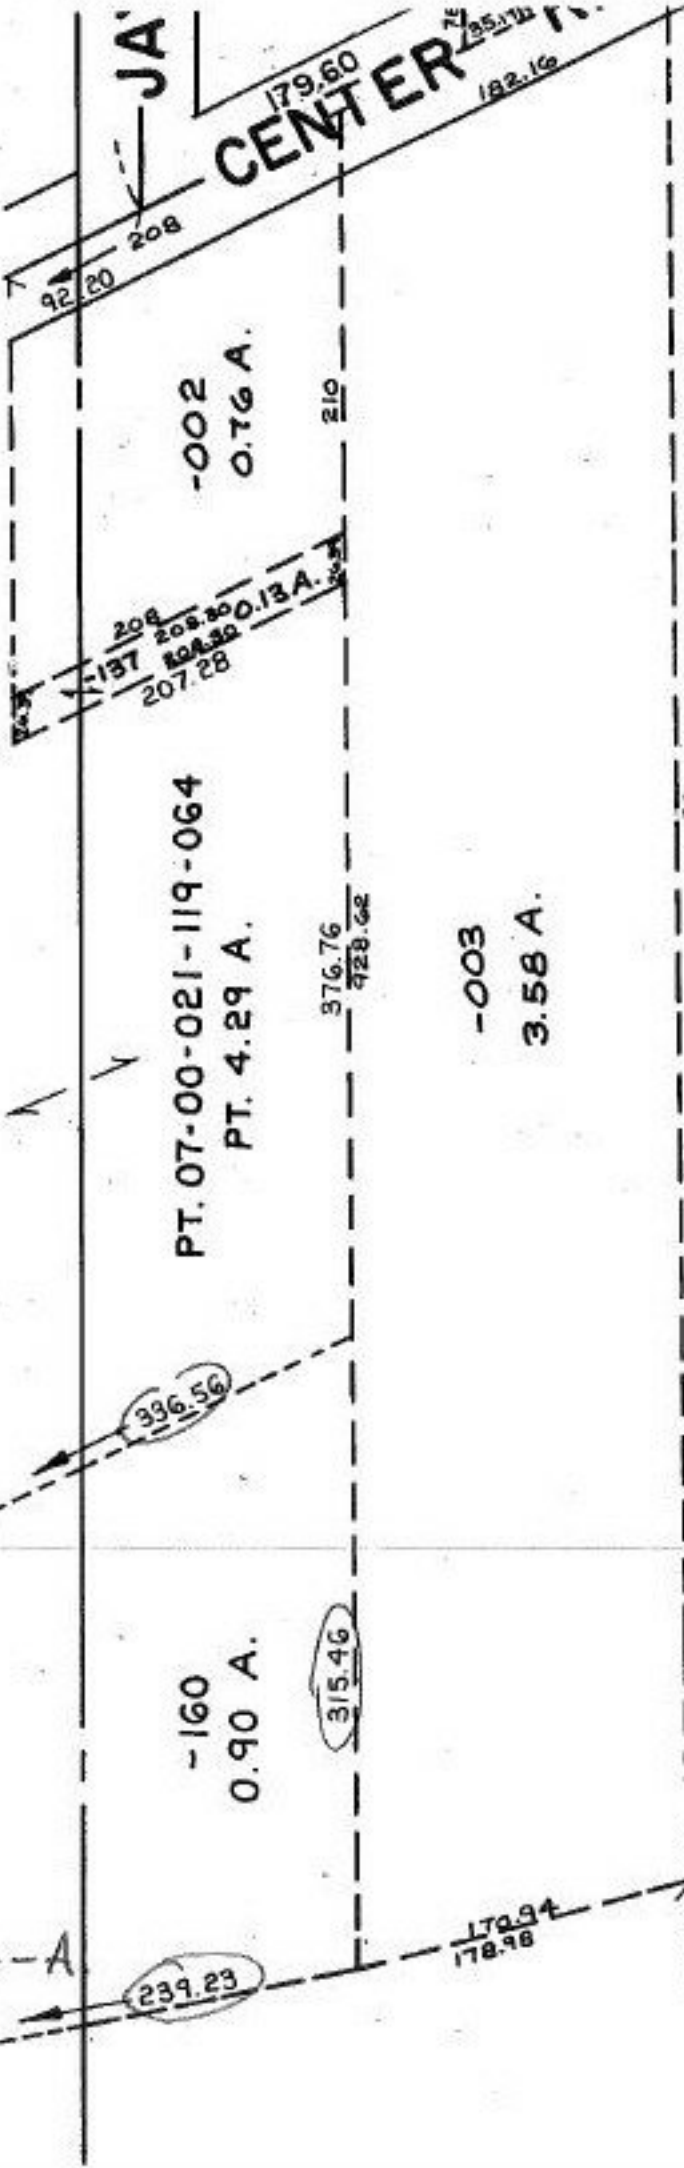

-002
0.76 A.

PT. 07-00-021-119-064
PT. 4.29 A.

-003
3.58 A.

-142
7.41 A.

-160
0.90 A.

#00362

APPROVED LORAIN CO. MAP DEPT
DATE 5-10-2000
PAGE 7-00-016-A
BY <i>J. Bolbert</i>
#00362

7-00-016-A

239.23

433.36

709.29