


SEE 4-00-017-A

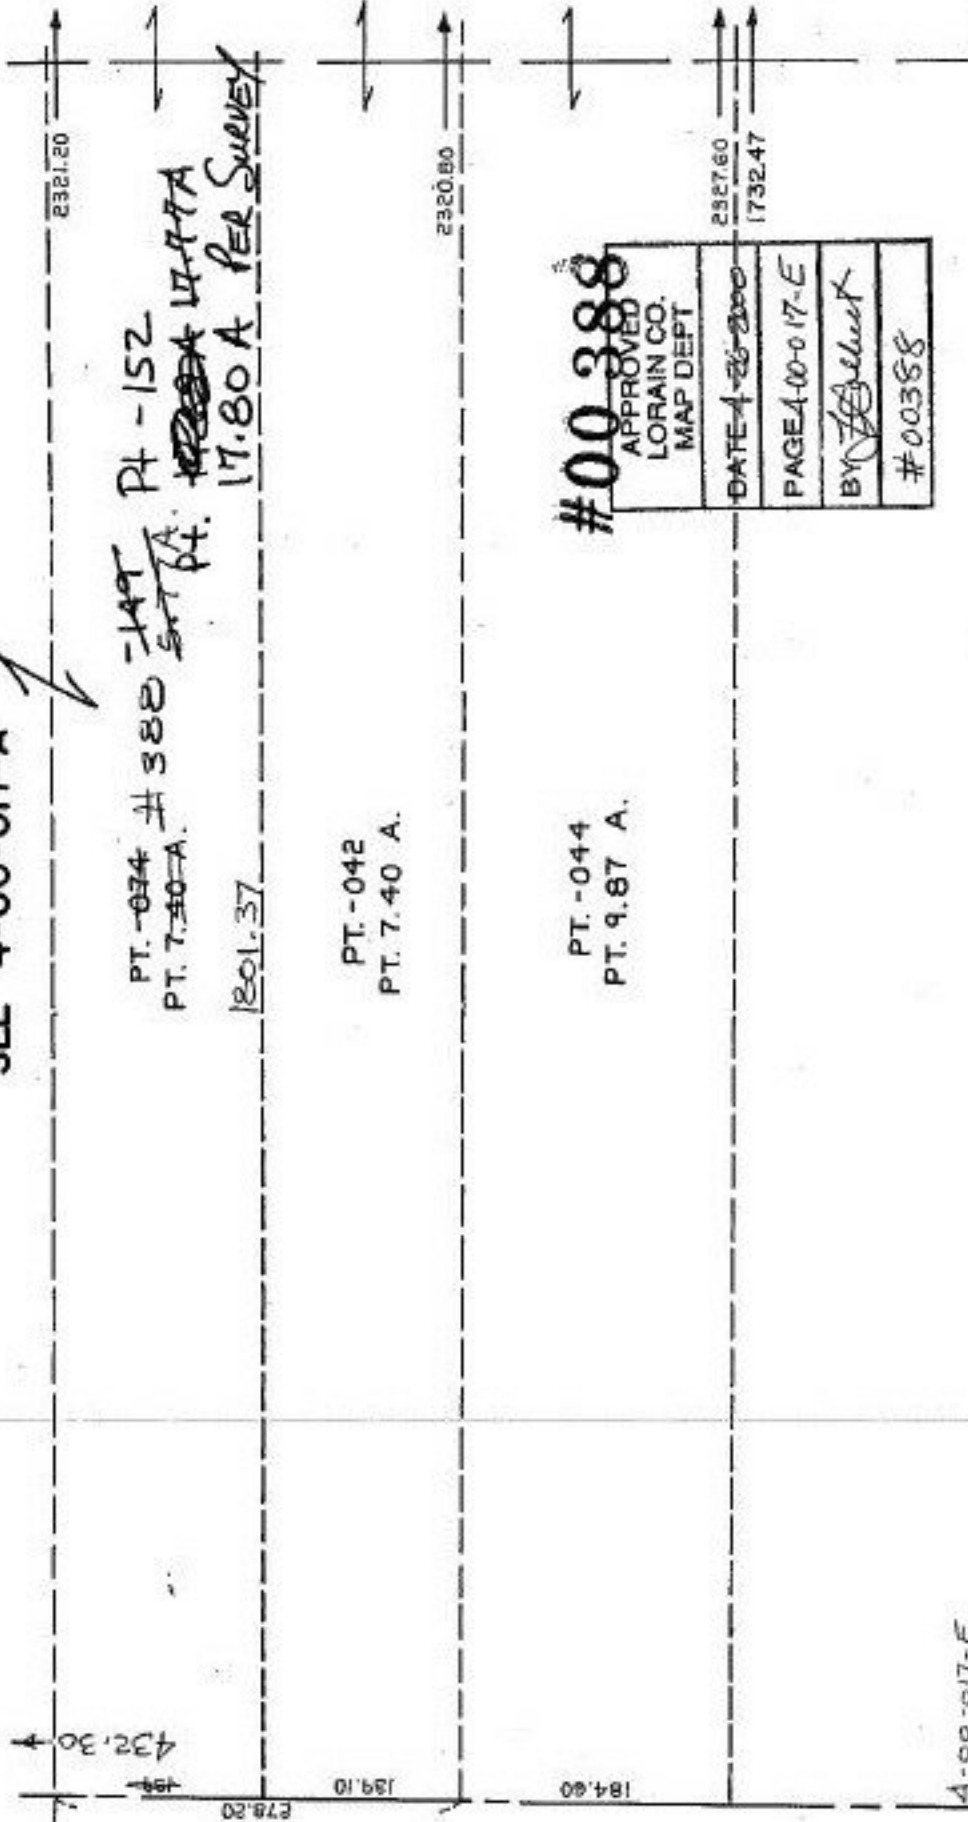

Σ