

SL

4-00-03-A

REM. FROM # 22601

H.P. SUB # 94

04-00-012-103-134

43.17A

REM. FROM # 22601

-134
PT. 04-00-012-103-123
PT. 49.43 A.
43.17A

SOUTH PARK DR # 22601

HIGHLAND PARK SUB. NO. 3

1952.87

2268.76

#00398


APPROVED LORAIN CO. MAP DEPT
DATE 4-17-2000
PAGE 4-00-013
BY <i>[Signature]</i>
#00398

-339
Pt. -336

Pt. 71.29A.
70.92A.

PT. -023
PT. 15.00 A.

PT. -070
PT. 10.00 A.

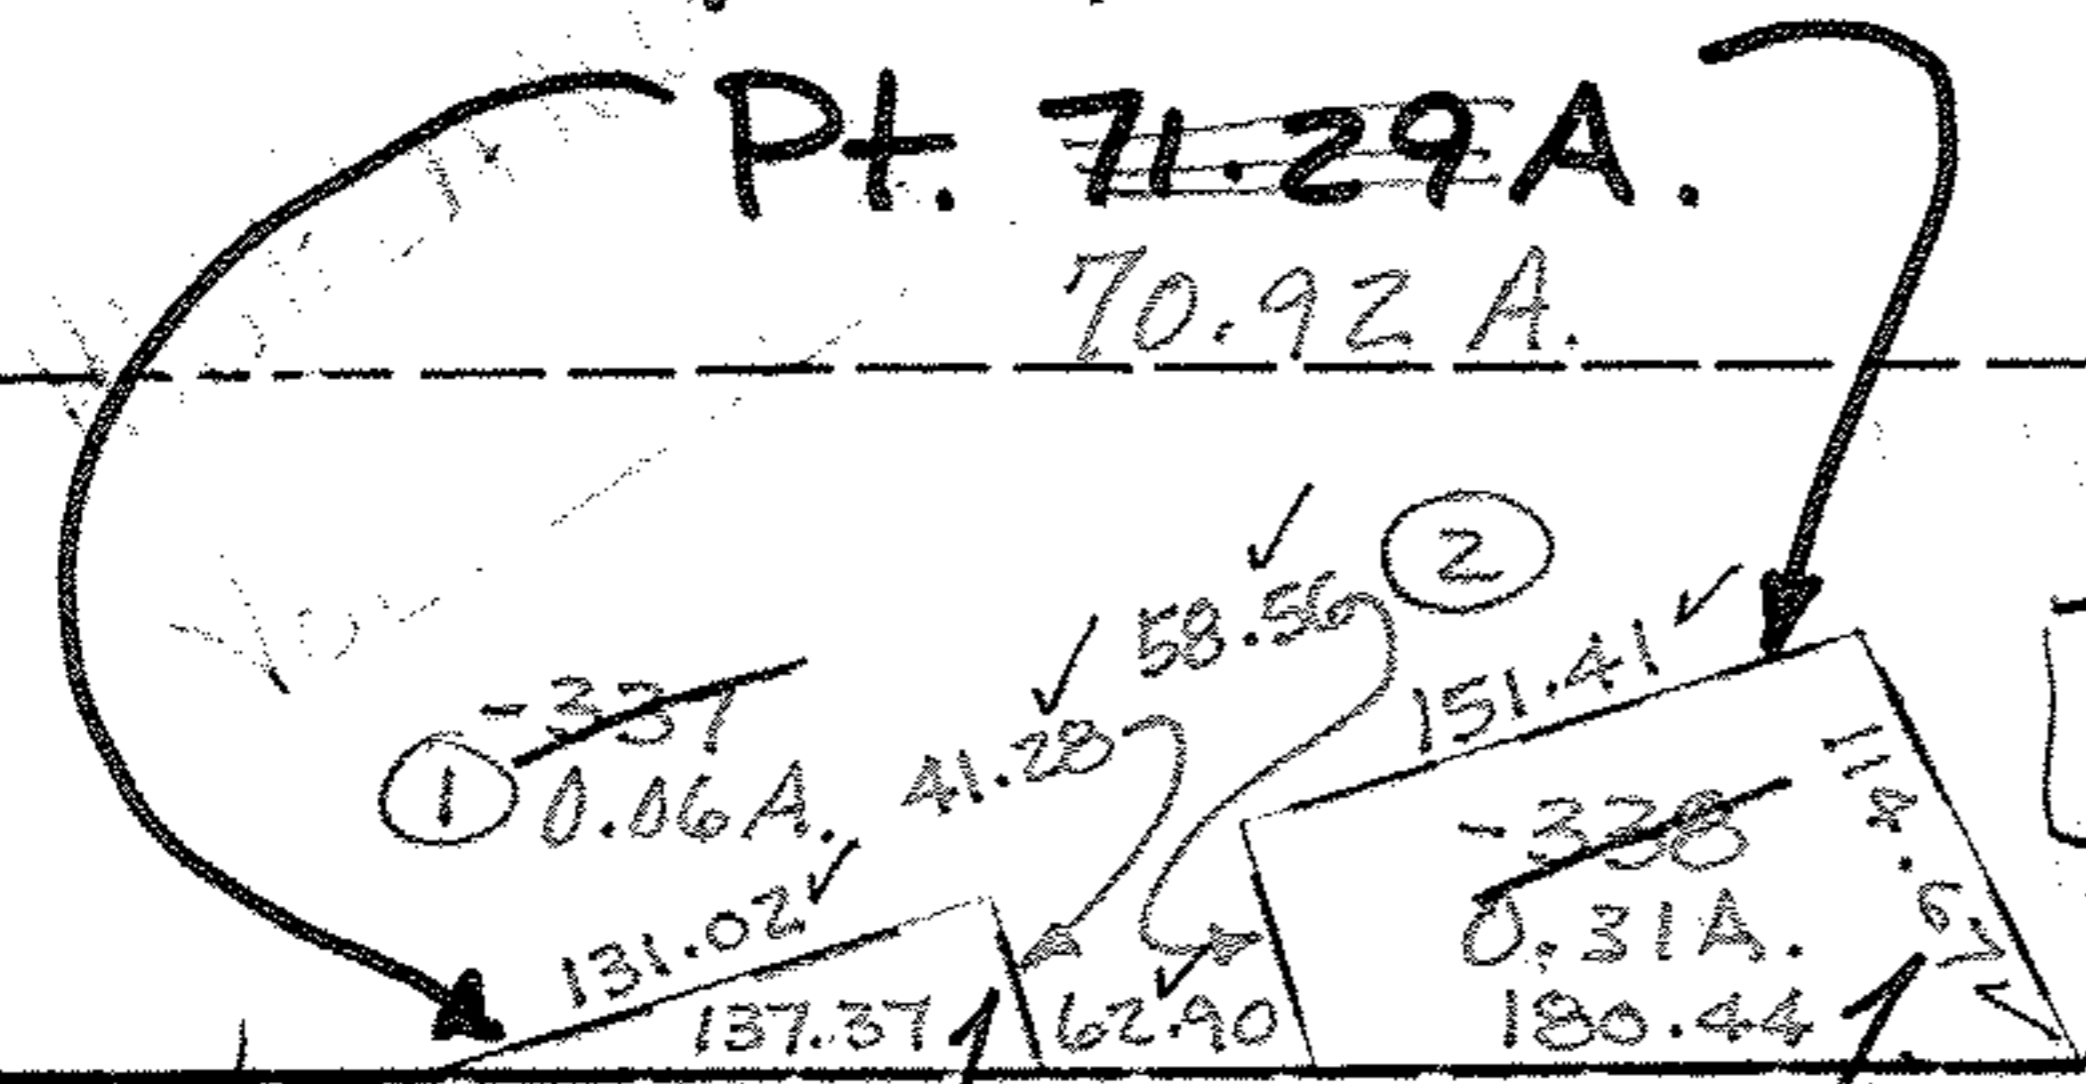

730.87 to SE CORNER HIGHLAND Pk. 5

PT. 2.50 A. 464.68

1576.31 to S.R. 82

-340
5.37A.

③ -340
5.00A

PT. -025
PT. 6.79 A.

④ Pt. -341
Pt. 4.29A.
6.73A. PER SURVEY
1577.47

1099.43

193.07

2676.90

203.54
162.80

203.14