

4-00-013-A

04-00-012-103-134

43,17 A


REM. FROM #22601

REM. FROM #22601

PT. 04-00-012-103-123  
PT. 4473 A.  
43.17 A

PT. -339  
~~PT. -336~~

PT. 71-29 A.  
70.92 A.

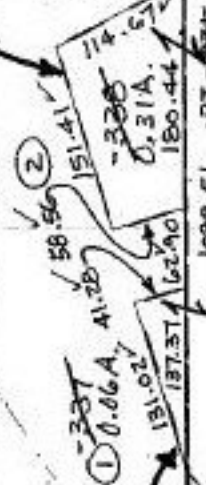

PT. -023  
PT. 15.00 A.

PT. -070  
PT. 10.00 A.

~~PT. -340~~  
PT. 5.00 A

1099.43

PT. -025  
PT. 6.74 A.

REM. FROM #22601

PARK DR  
#22601  
SOUTH

HIGHLAND PARK  
SUB. NO. 3

59 58 57

#00398

APPROVED LORAIN CO. MAP DEPT
DATE 4-17-2000
PAGE 4-00-013
BY <i>[Signature]</i>
# 00398

PT. 2-50 A. 464.68

PT. 2-89 to SE corner Hatched Pt. 5

254.11

162.80

198.07

1576.31 to E S.R. 88

④

PT. -341

PT. 4.27 A.

6.73 A. PER SURVEY

1577.47

2076.90

203.14