

HABANT


RD.

SUB.
R-25

BEVERLY

BEVERLY


103

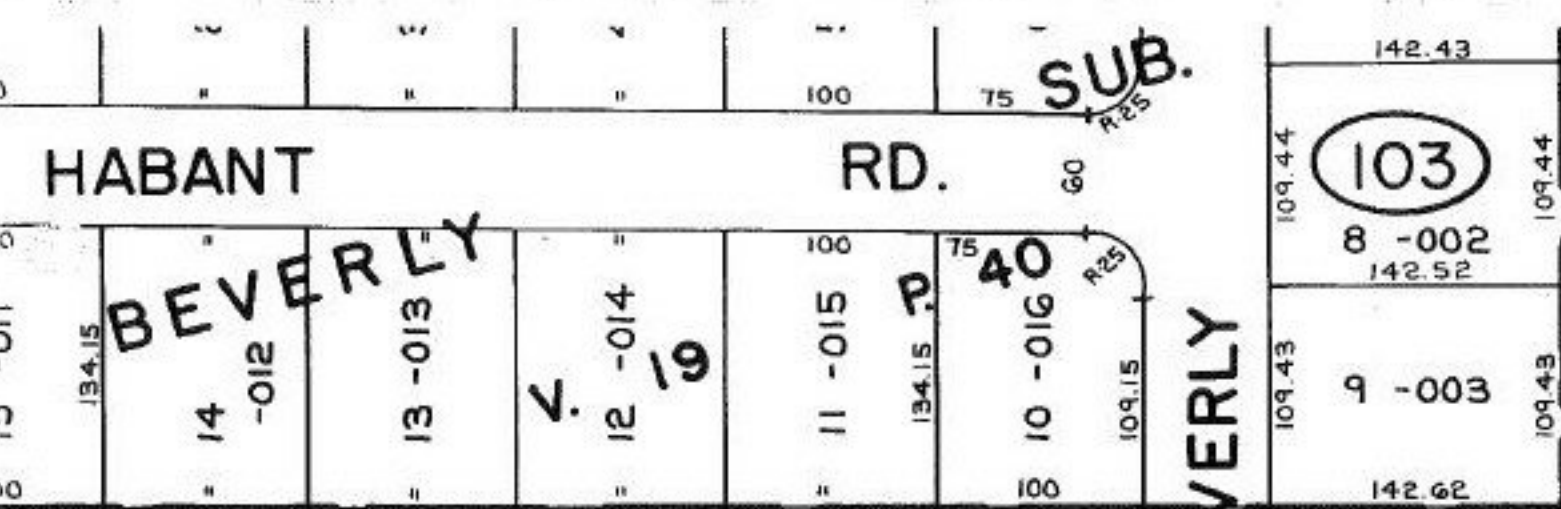

PT. -075
PT. 4.47 A.

-072
0.40 A.

-004
0.40 A.

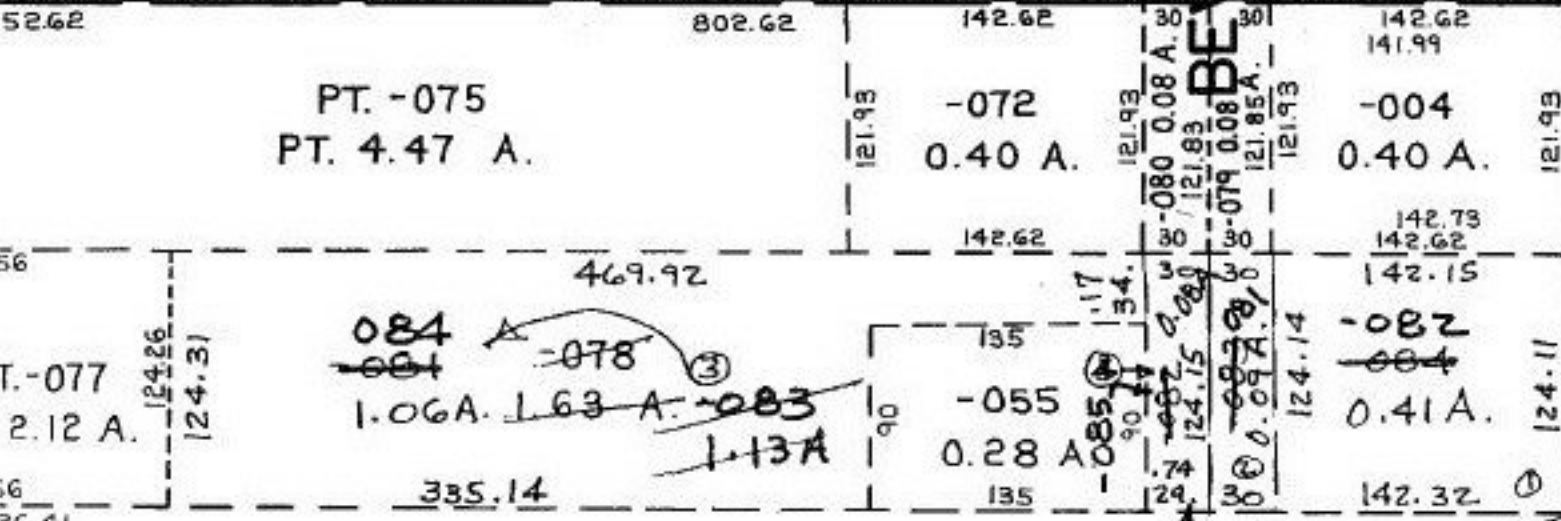

~~084~~
~~084~~
1.06A. 1.63 A. ~~083~~
1.13A

-055
0.28 A.


~~082~~
~~084~~
0.41 A.

0.07A
0.08A
Per Survey

#00400

PT. -054
PT. 14.32 A.

APPROVED LORAIN CO. MAP DEPT
DATE 4-12-2000
PAGE 2-02-001-B
BY <i>[Signature]</i>
#00400

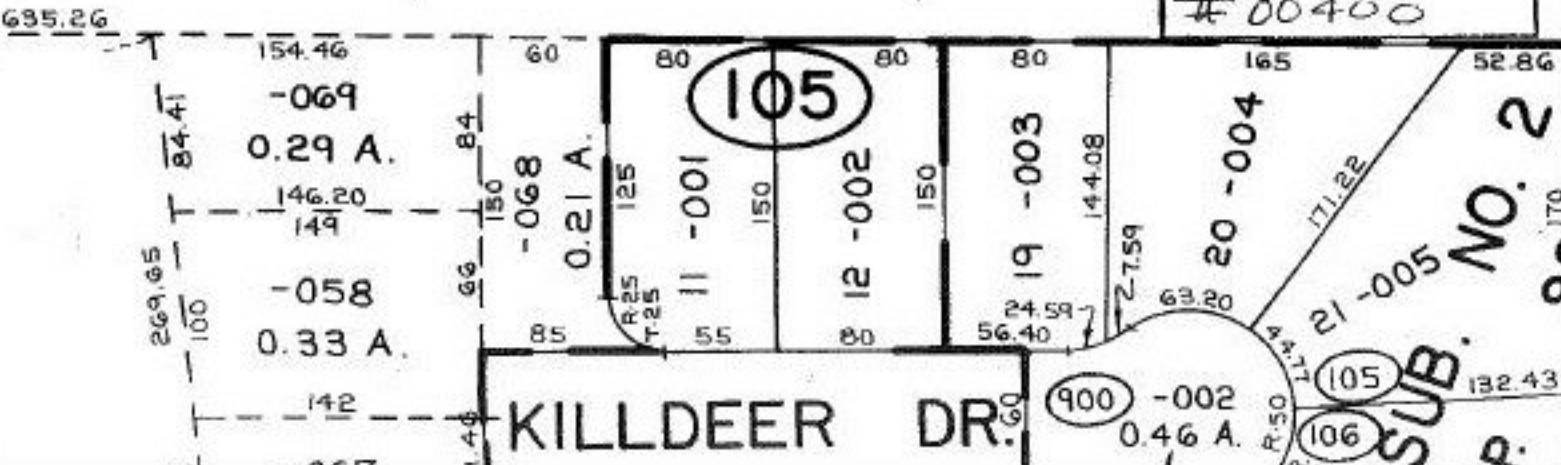

105

KILLDEER DR.

900 -002
0.46 A.

SUB. NO. 2
P.

SEE 2-02-002-A