


EE

12-A

2.85

12-00-086-000-028,029,011,010,
010,110,020,980-000,980-008

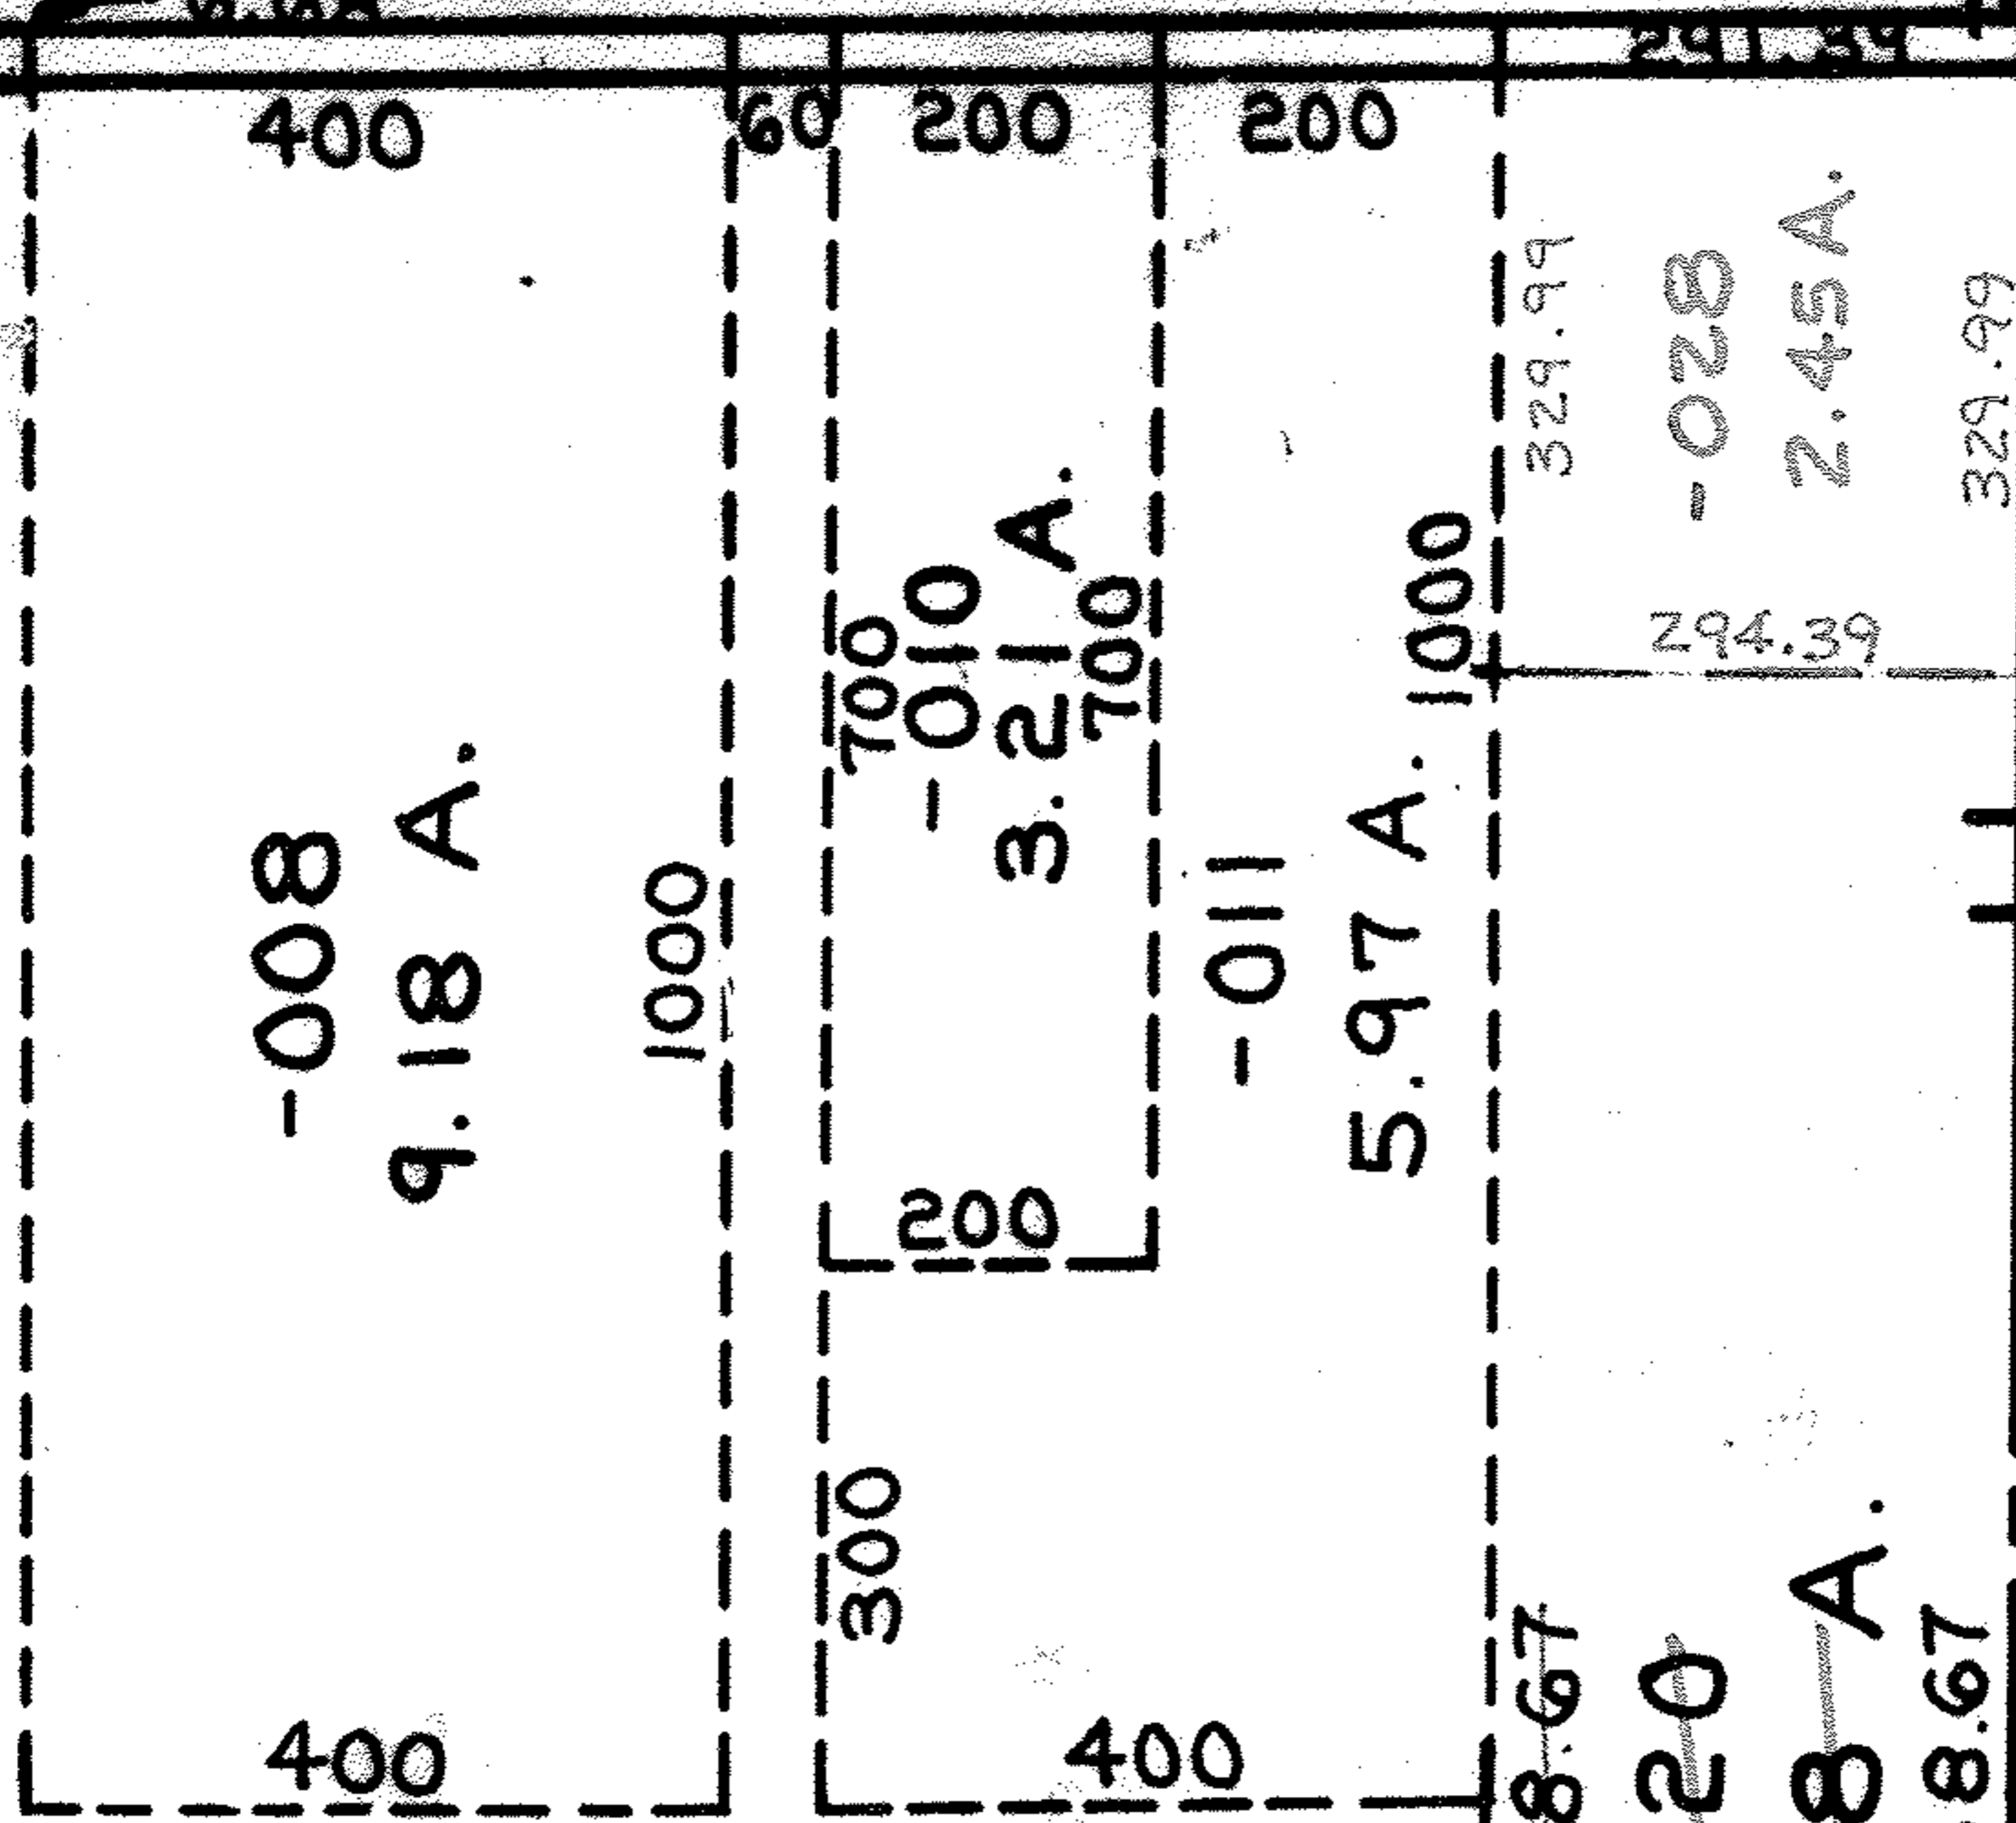

6

- 019 #00412
49.16 A.

APPROVED LORAIN CO. MAP DEPT
DATE 4-26-2000
PAGE 12-E
BY J. Collett
00412

068.67

1705.68 2068.67

~~-029 -020~~
Per Survey
~~4.53A. 13.98 A.~~
11.52A
1738.68 2068.67

294.39

LYDIA RD.