


010-24-040-102-043,-044

#00417

APPROVED LORAIN CO. MAP DEPT
DATE 5-9-2000
PAGE 6-41
BY <i>J. Elliott</i>
#00417

Copyright 1963
2-4-00

6-41

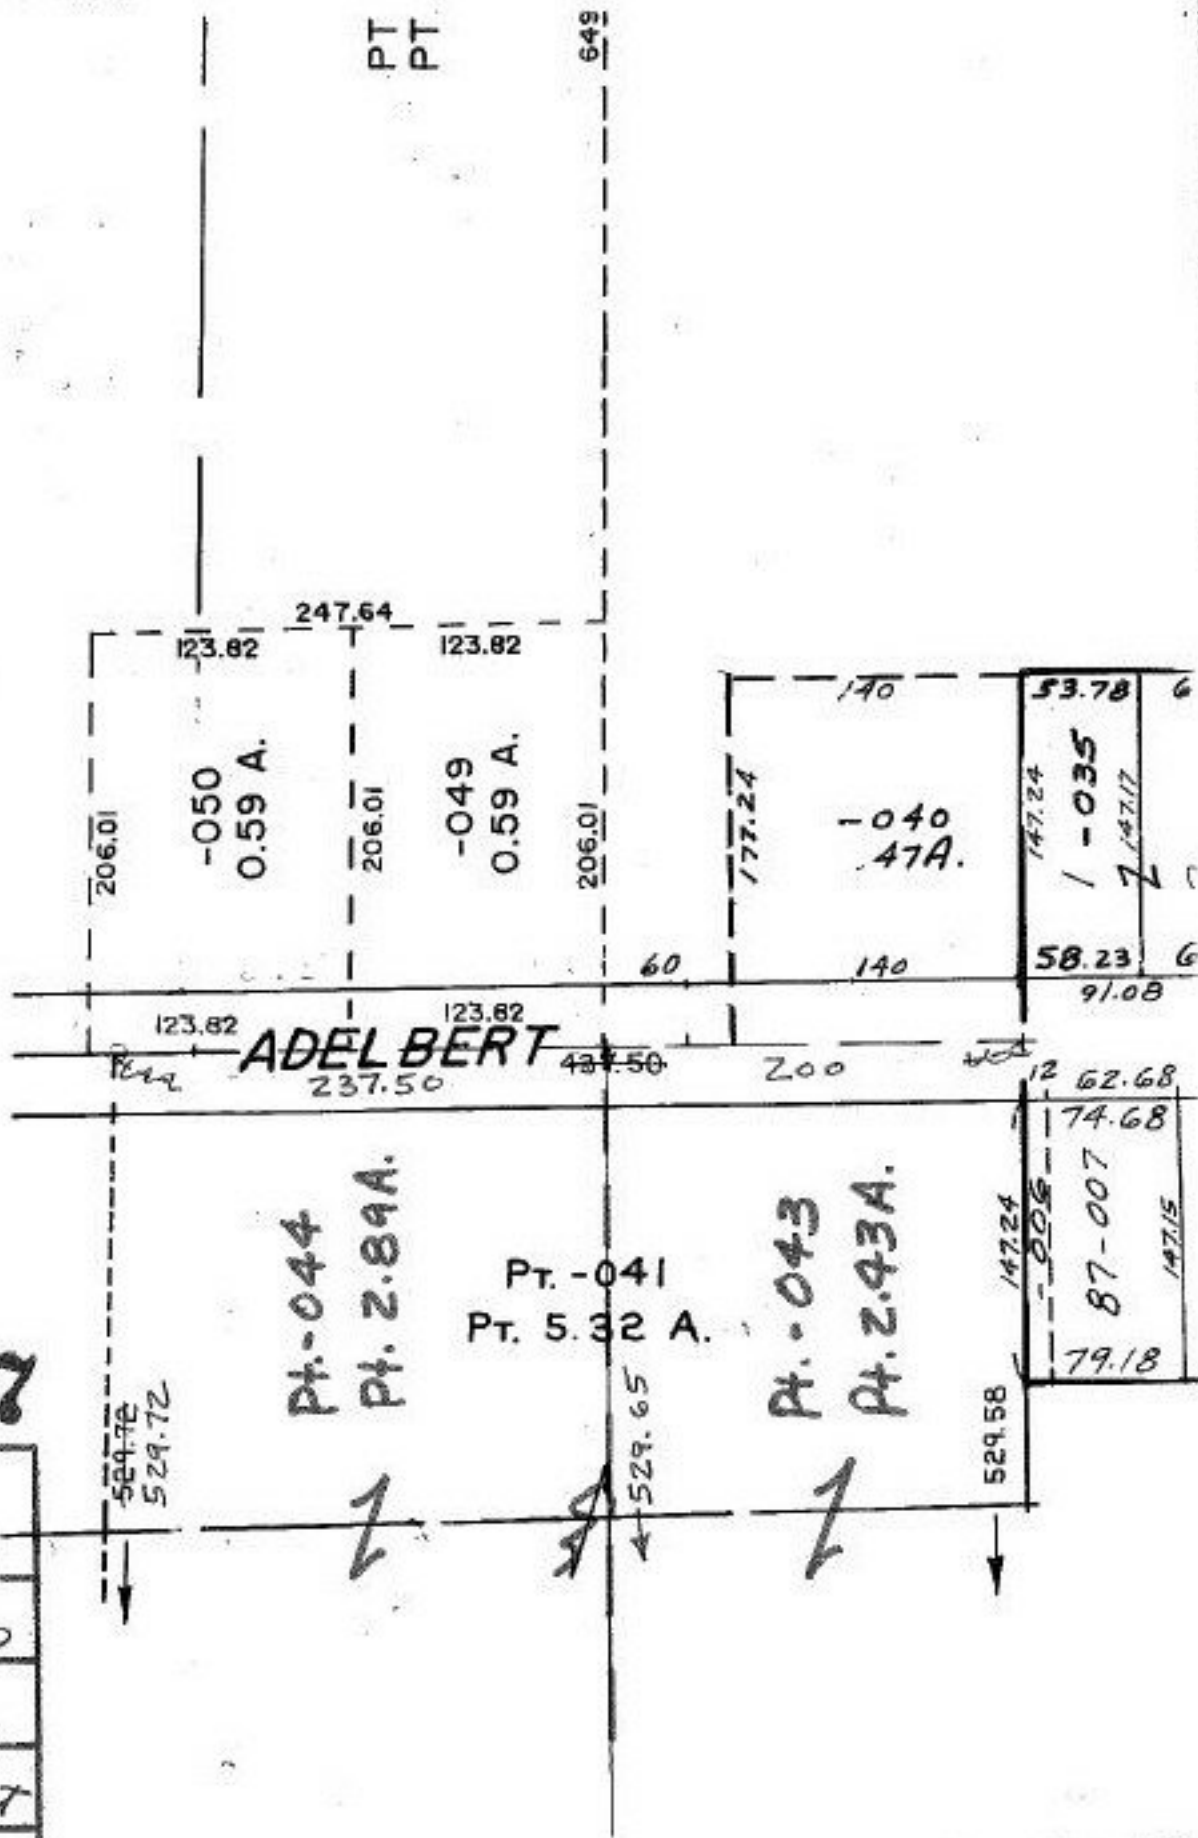

BRACE TRACT SEly PT
WEST OF RIVER Ely PT.