

PARENT PARCEL: 08-00-097-000-027, -010

CHILD PARCEL: 08-00-097-000-048 THRU -050


STARTING POINT: AT A PK NAIL SET IN THE C/L OF GORE ORPHANAGE RD.

NO. 00418



~~-049~~
18.14 A.

~~-027~~
18.58 A.

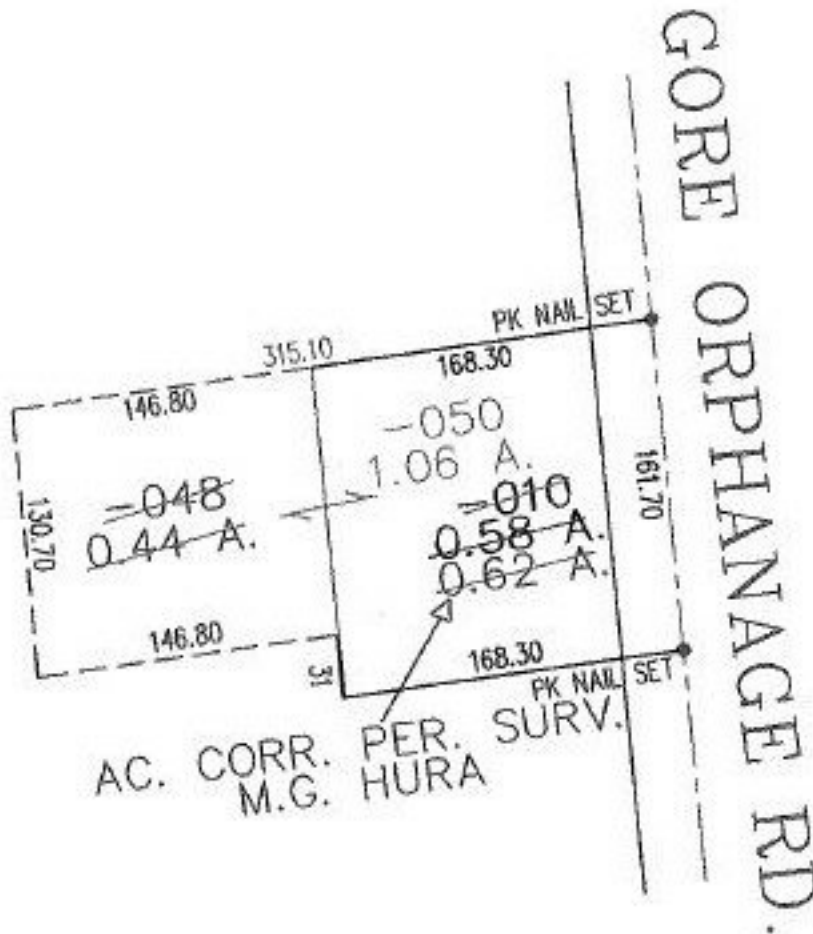

AC. CORR. PER. SURV.
M.G. HURA



SPLITS/DEEDS PROCESSED

LORAIN COUNTY TAX MAP DEPARTMENT
226 MIDDLE AVE. ELYRIA, OHIO

SURVEYED BY: M.G. HURA

CLOSURE: 00:10:000

MAP PAGE(S): 8-A

APPROVED BY: RRM DATE: 8-1-01

SCALE: 1" = 100' PRIOR INSTRUMENT: DV 946/451