


3-00-027-A

749.00

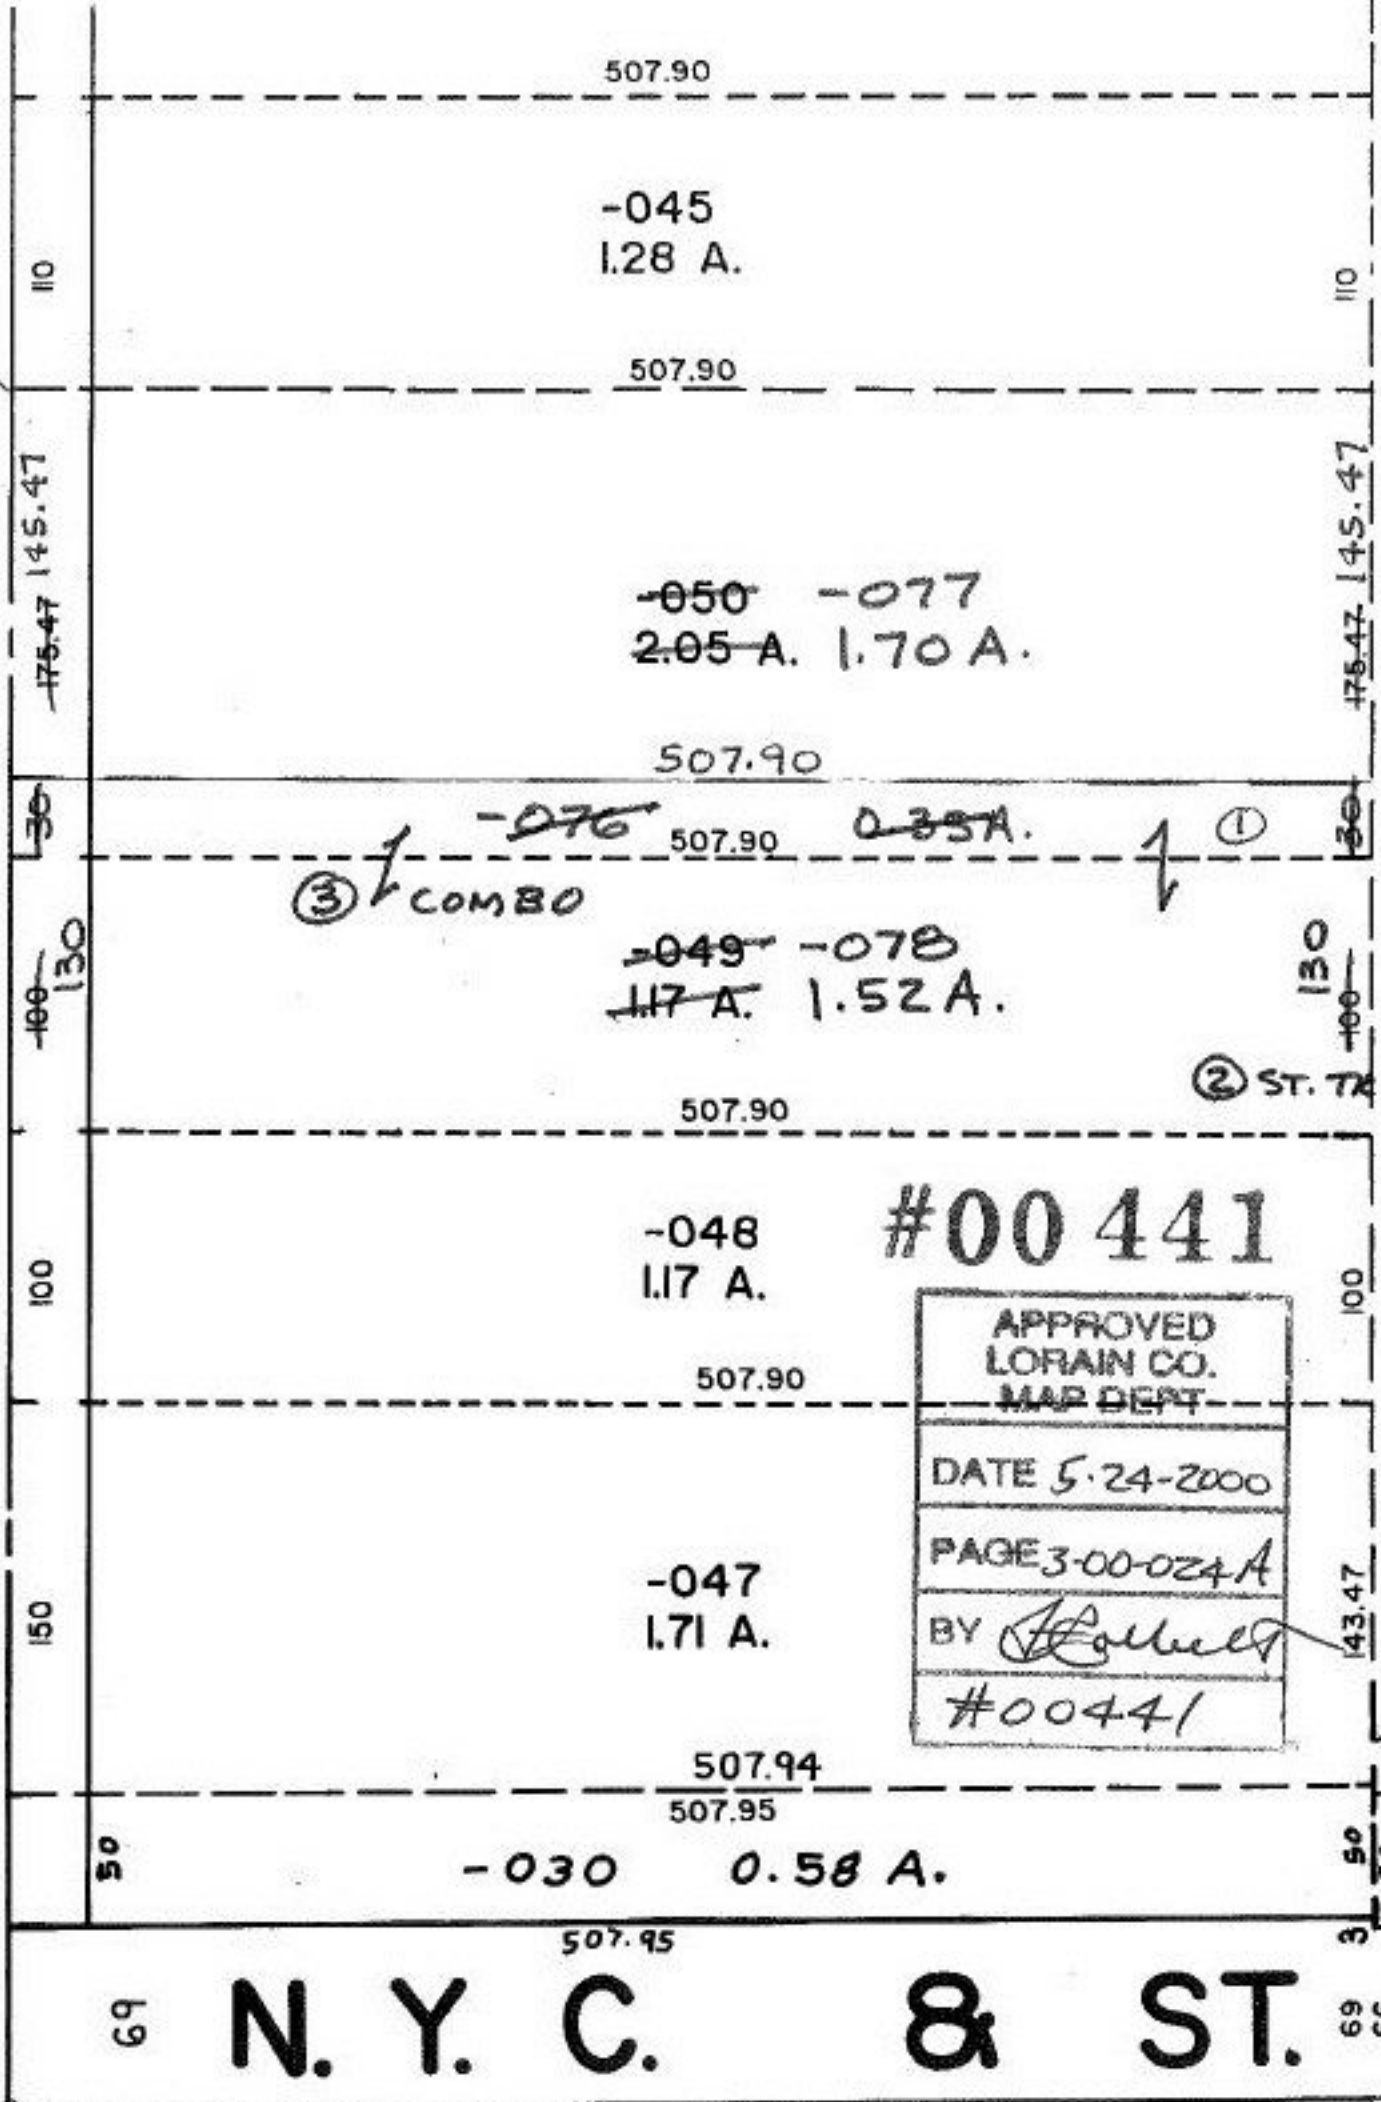

#00441

APPROVED  
LORAIN CO.  
MAP DEPT.

---

DATE 5-24-2000

---

PAGE 3-00-024A

---

BY *[Signature]*

---

#00441

1257.41

69

N. Y. C. & ST.

66

508.49