


-116

PT. -114  
PT. B2.92  
B2.42 A.

#00 529

APPROVED LORAIN CO. MAP DEPT
DATE 8-17-2000
PAGE 18-00-020
BY <i>J. Eubank</i>
529

380

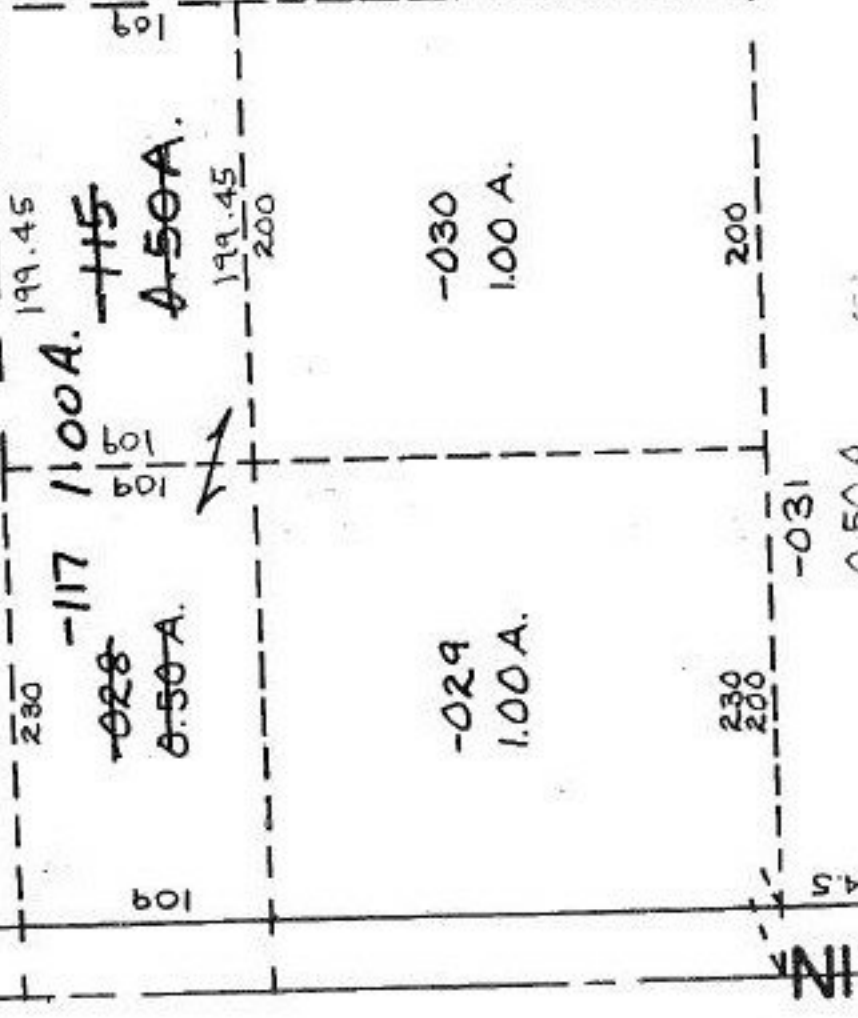

400

-032  
0.50 A.

SEE 18-B