


SEE II - B

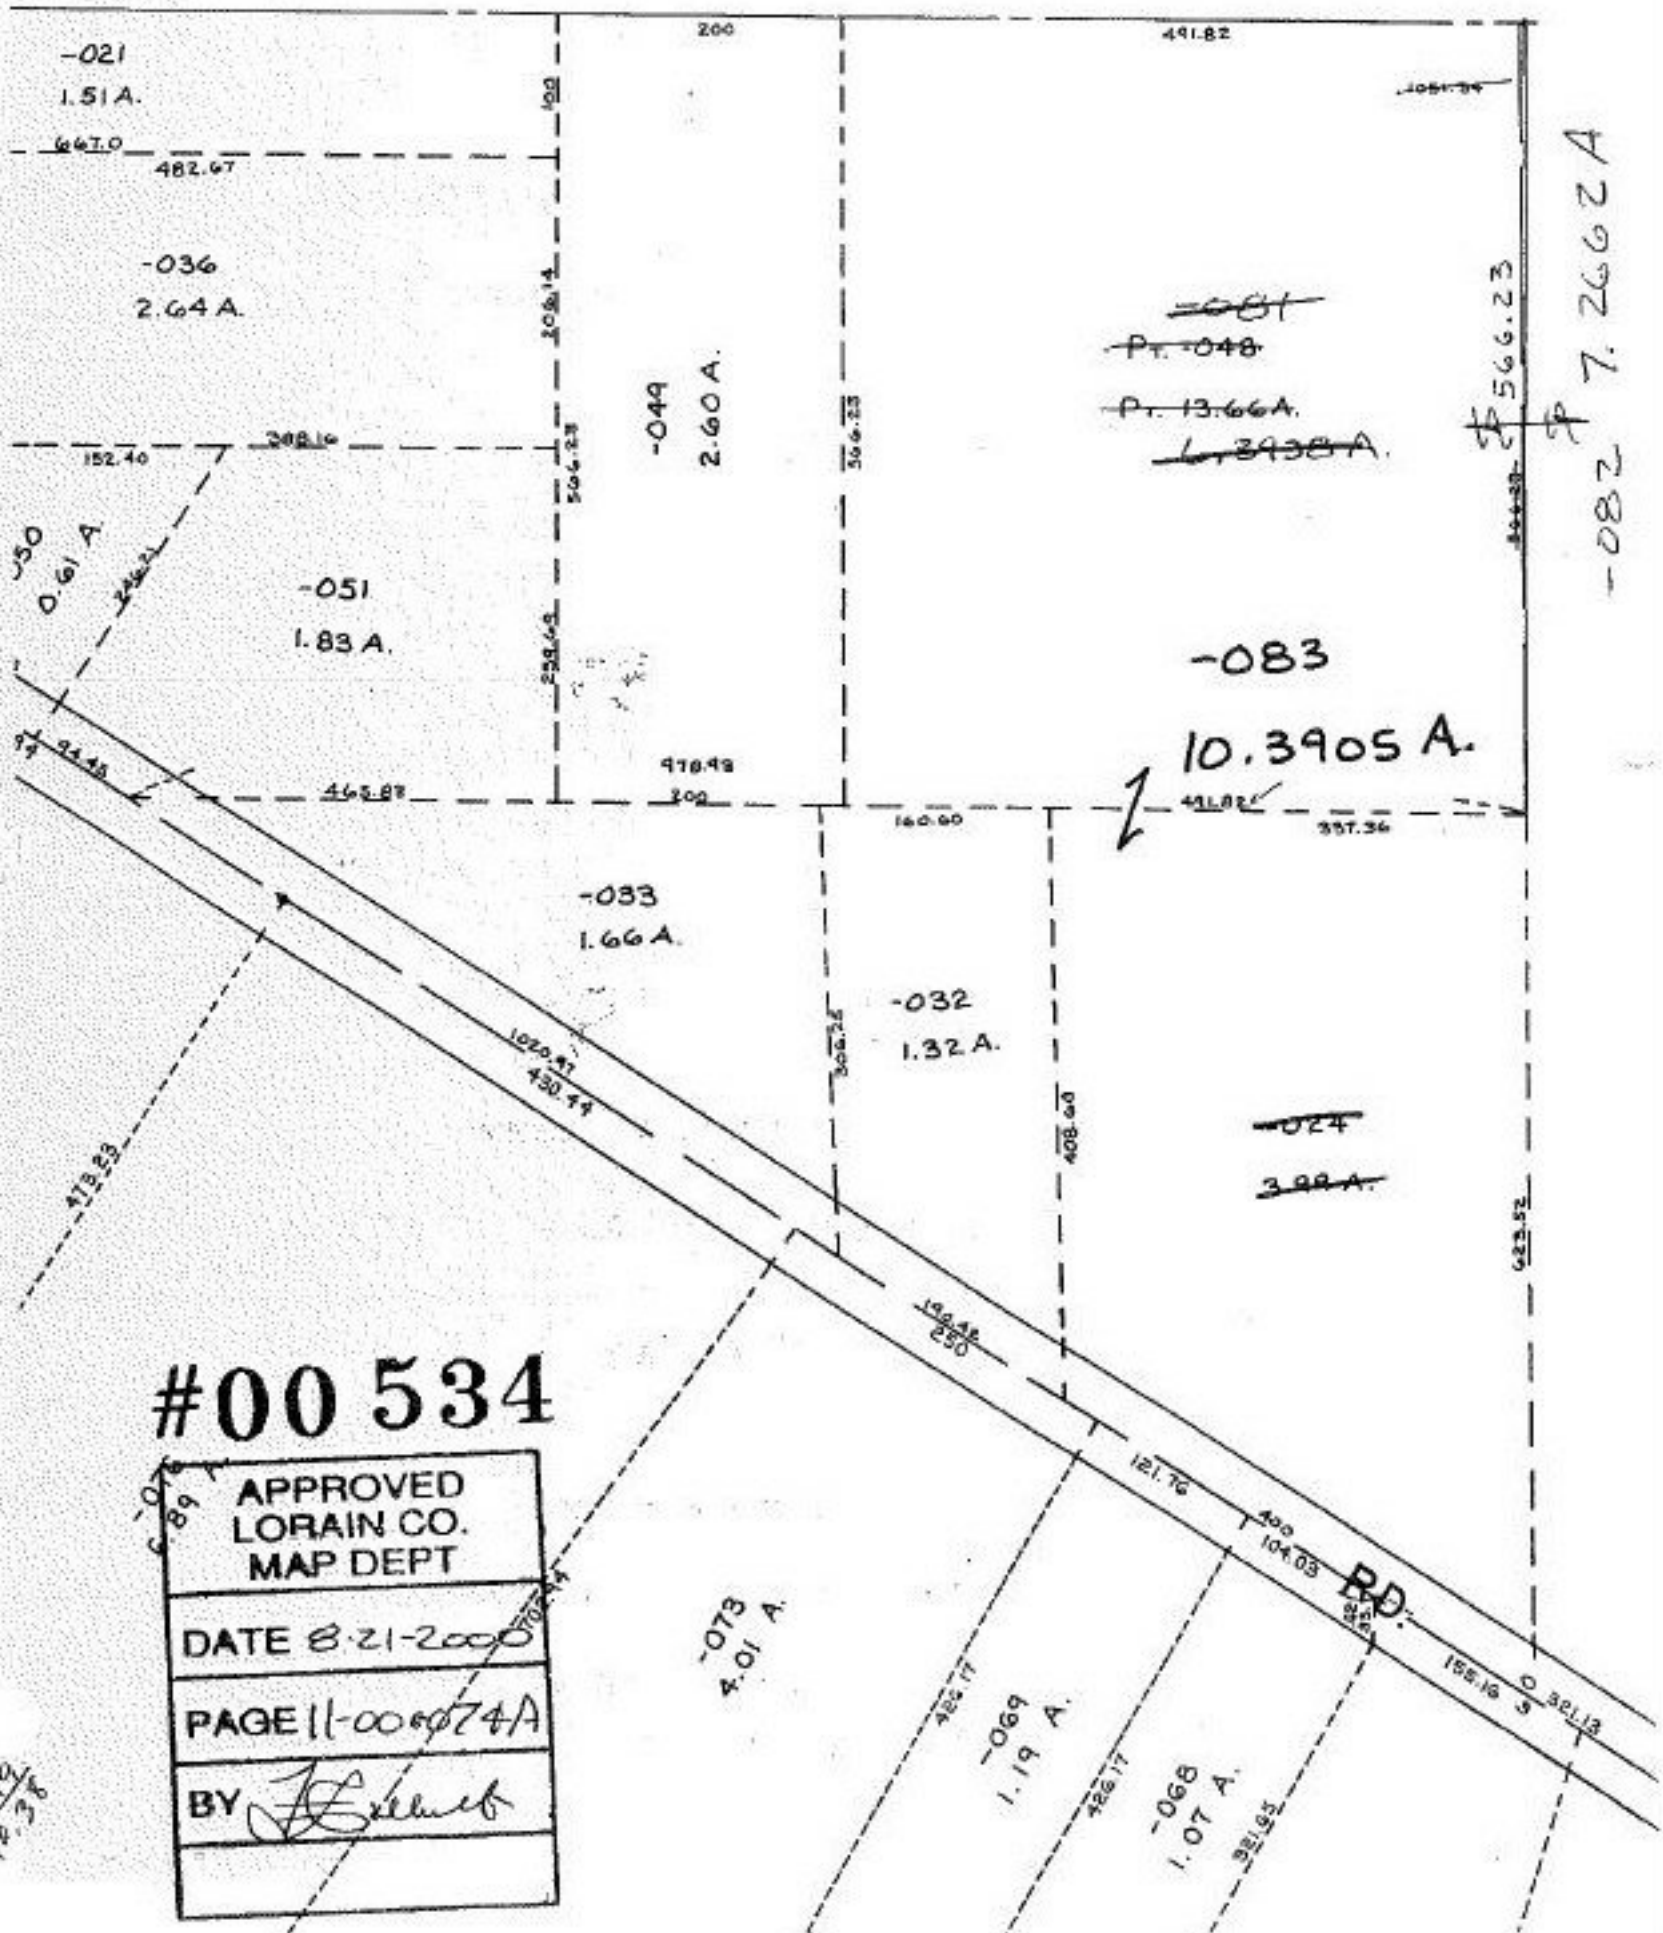

#00534

APPROVED LORAIN CO. MAP DEPT
DATE 8-21-2000
PAGE 11-006074A
BY <i>[Signature]</i>

67
390
10.38