



RASTER

PARENT PARCEL: 01-00-004-120-023, 048

CHILD PARCEL: 01-00-004-120-000-055, 056

STARTING POINT: CENTERLINES OF SUNNYSIDE RD. & LIBERTY AVE.

NO. 00536

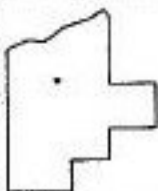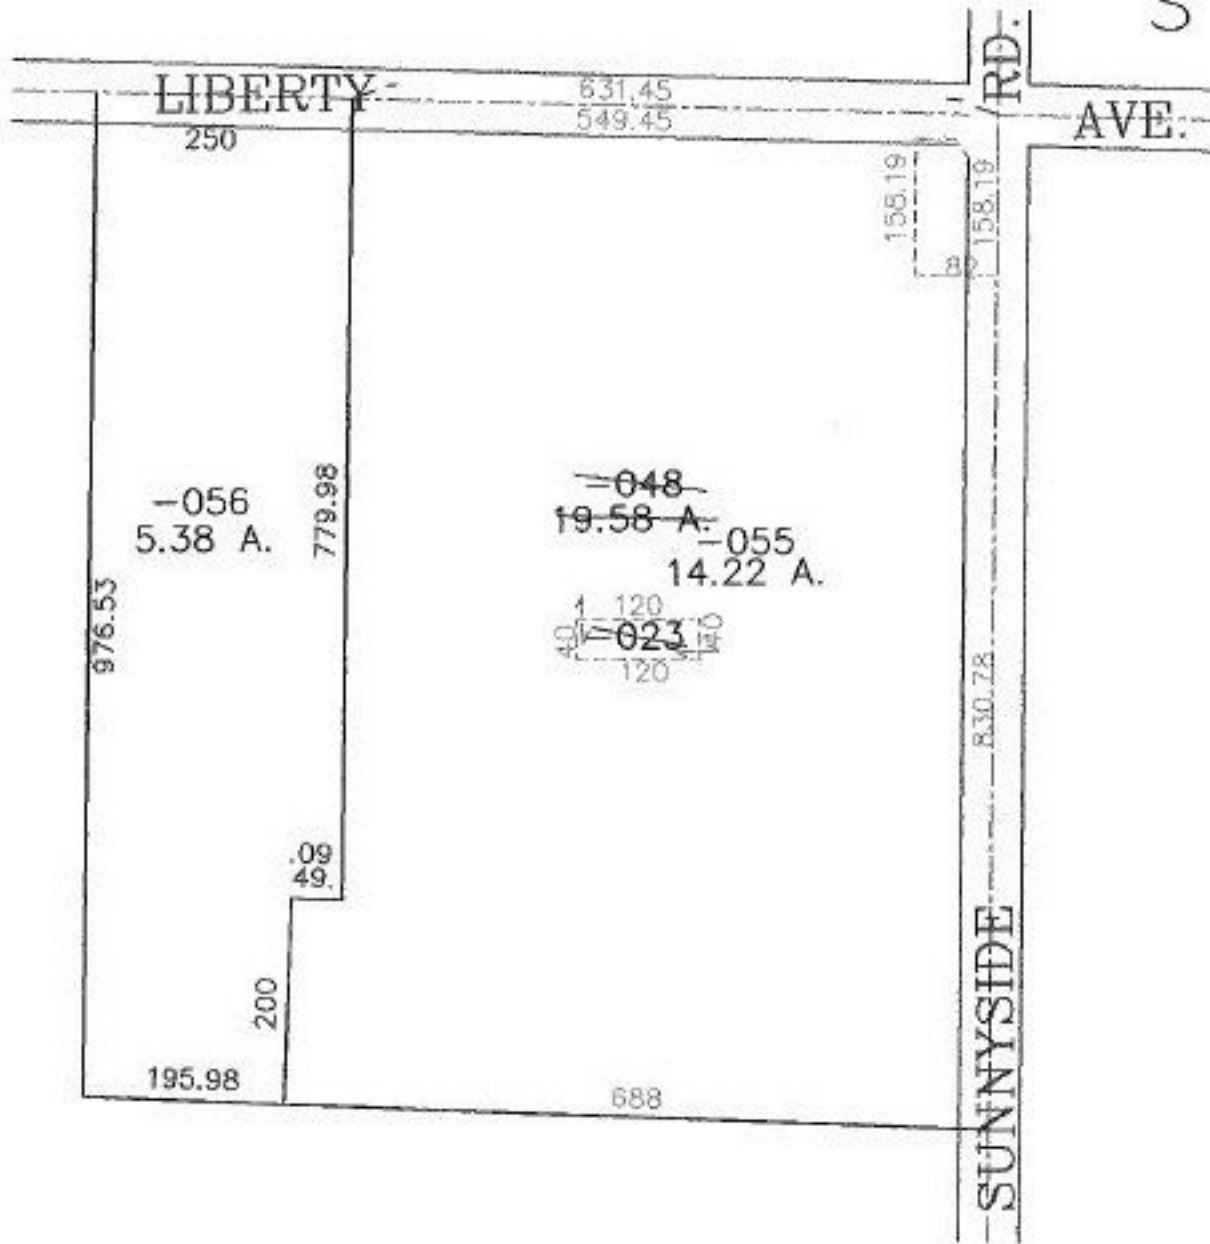

SPLITS/DEEDS PROCESSED
 LORAIN COUNTY TAX MAP DEPARTMENT
 226 MIDDLE AVE. ELYRIA, OHIO

SURVEYED BY: M.G. HURA
 CLOSURE: 0.03 : 10.000
 MAP PAGE(S): 1-00-004-D
 APPROVED BY: JAH DATE: 8-25-00
 SCALE: 1" = 200' PRIOR INSTRUMENT: OR 1336/544