


SEE 9-00-096-B

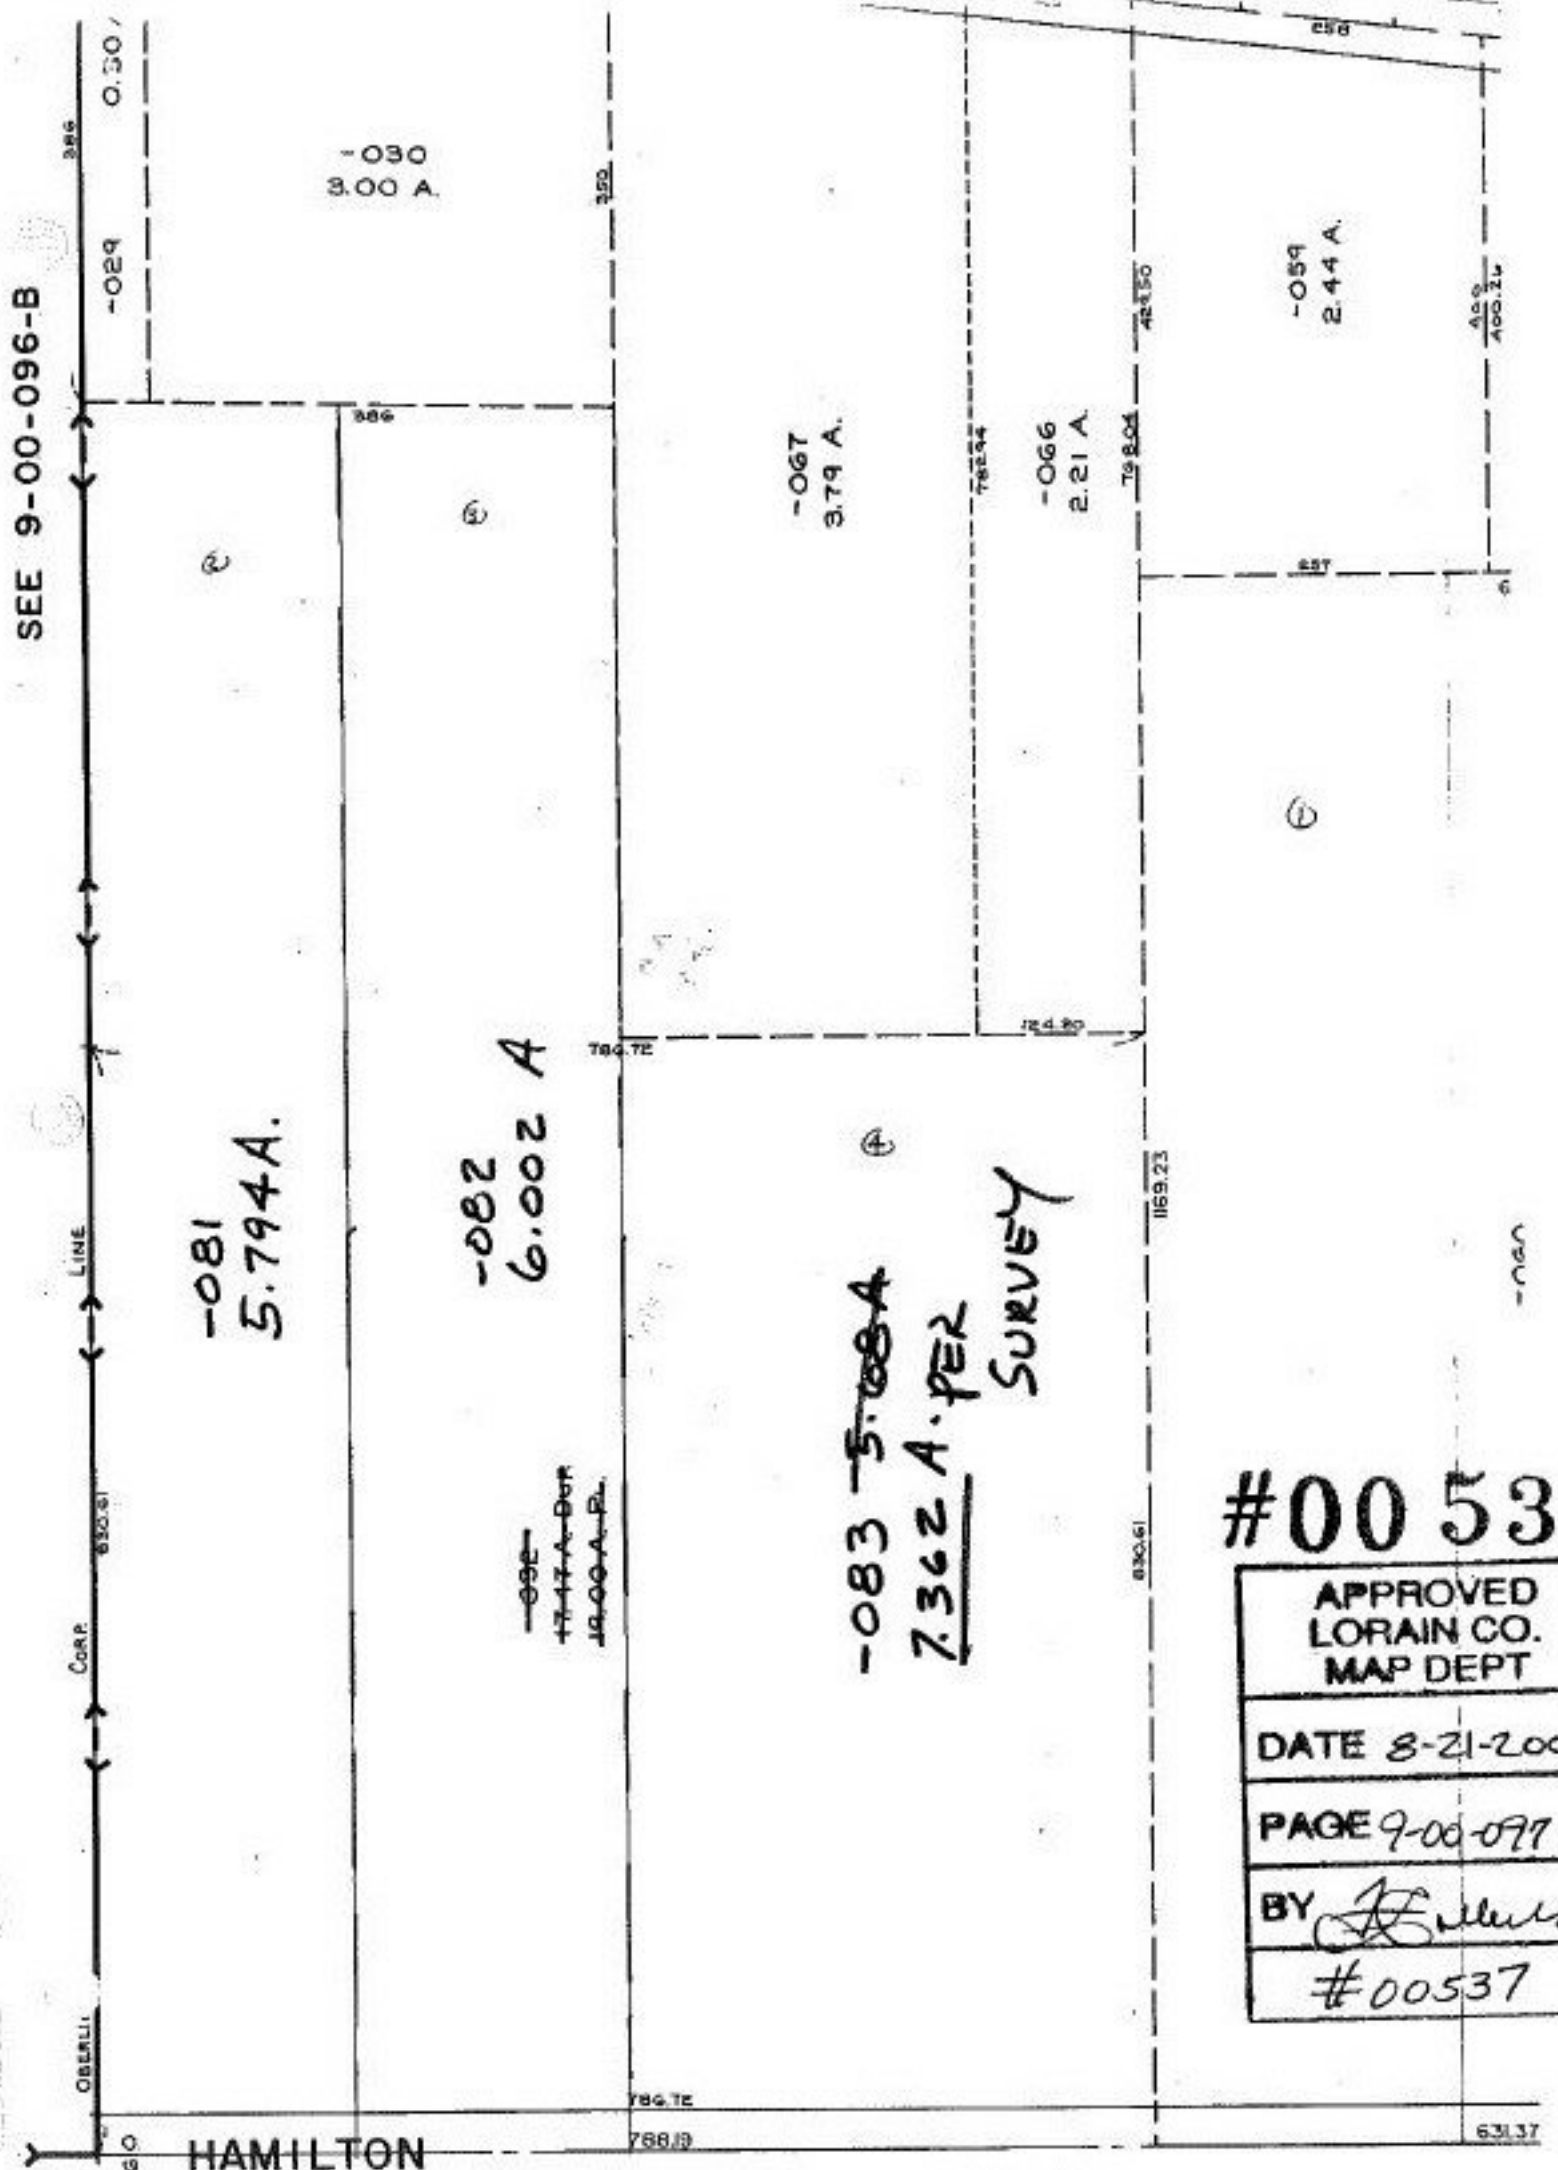

-081
5.794 A.

-082
6.002 A

-083 ~~5.008 A~~
7.362 A. PER
SURVEY

-067
3.79 A.

-066
2.21 A

-059
2.44 A.

-030
3.00 A.

-029
0.50 /

-058
100.12

#00537

APPROVED LORAIN CO. MAP DEPT
DATE 8-21-2000
PAGE 9-00-097 A
BY <i>[Signature]</i>
#00537

HAMILTON

SEE 9-G